


T. 2 N., R. 12 E., W.M.

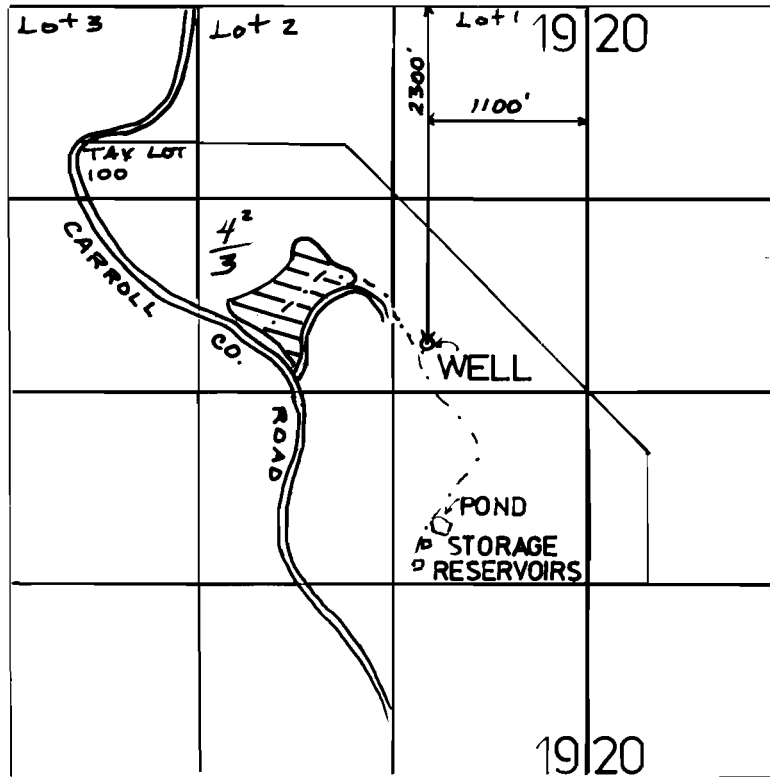

1" = 1320'

FINAL PROOF SURVEY

UNDER

Application No. G-11224 Permit No. G-10915
IN NAME OF

AMERICAN ADVENTURE, INC.

Surveyed JULY 15, 1998, by J. MILLER