


T. 3 & 4 N., R. 1 & 2 W., W.M.

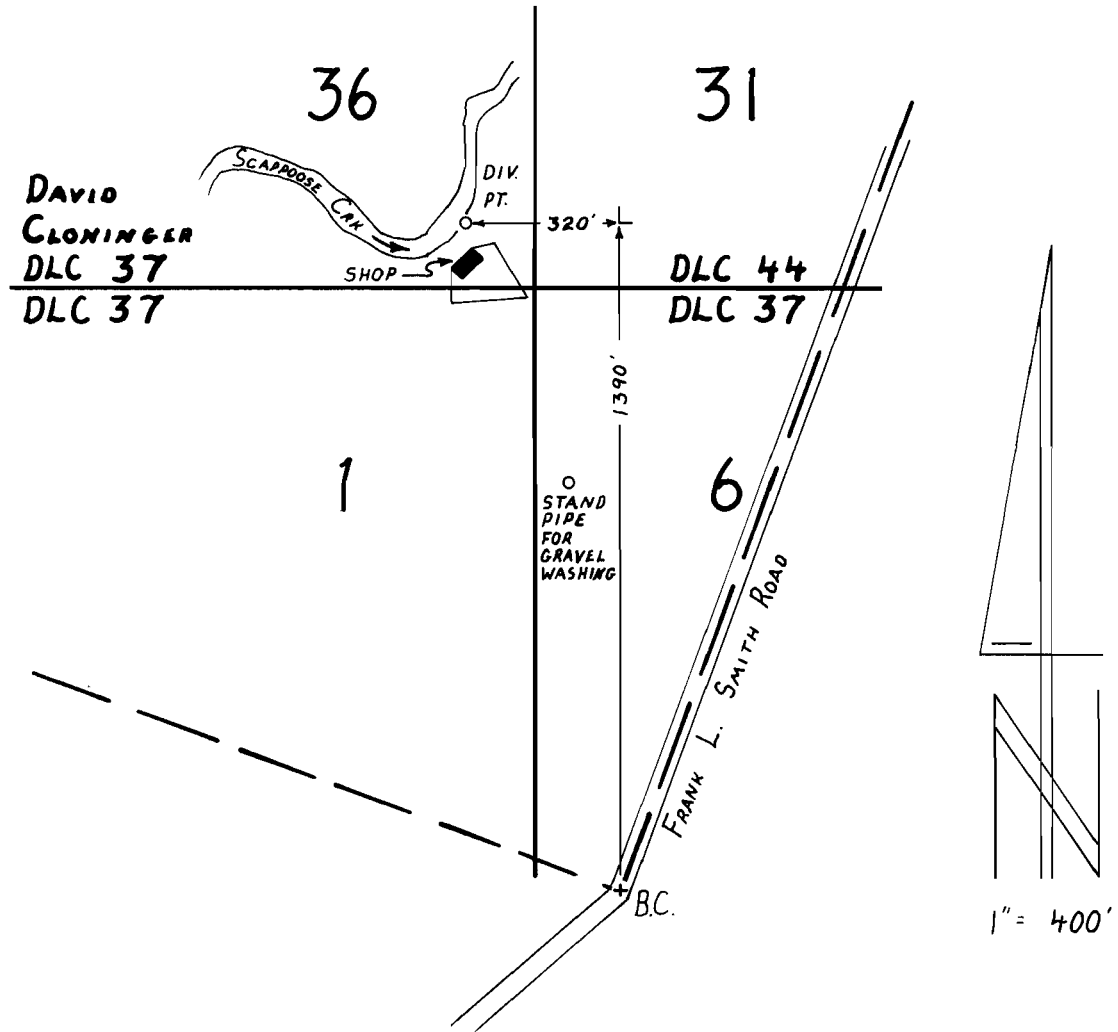

FINAL PROOF SURVEY

UNDER

Transfer No. 4271

In Name Of

J.O. FISHER, SR. & WARREN SAND & GRAVEL CO.

Surveyed October 9, 1991, by R.W. Klassen