


T. 7 S., R 21 E., W.M.

TRANSFER
APPLICATION MAP FOR
LUREN MALEY


RECEIVED
DEC 8 1980
WATER RESOURCES DEPT
SALEM, OREGON

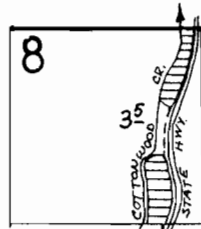

APPROVED

Luren Maley

old POD C-25990

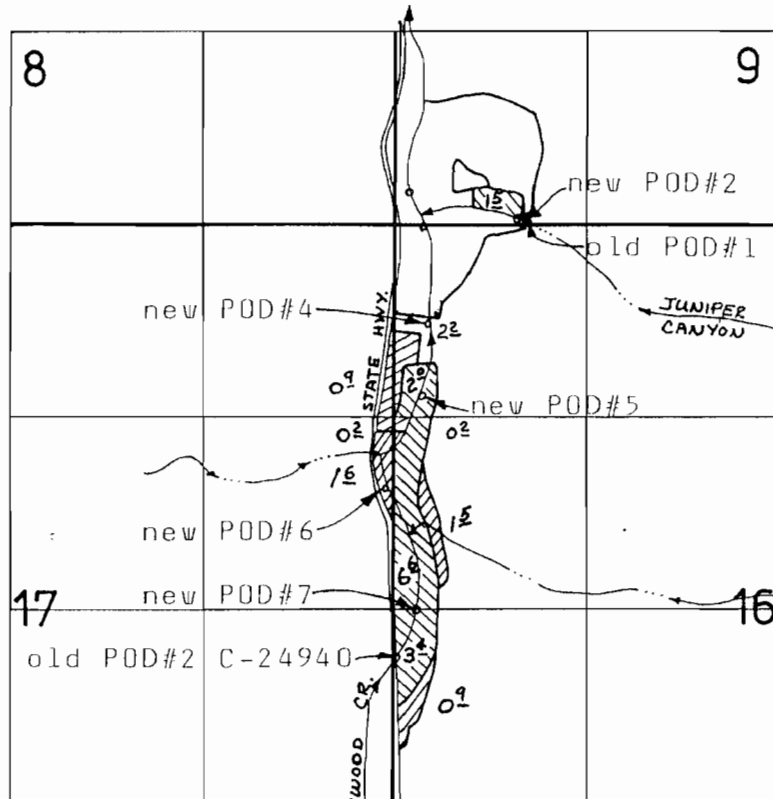

N
SCALE
4" = 1mi

POD#2 50' N & 840' E of NW cor Sec.16
POD#4 690' S & 230' E of NW cor Sec.16
POD#5 1180' S & 180' E of NW cor Sec.16
POD#6 1800' S & 40' W of NW cor Sec.16
POD#7 2640' S & 160' E of NW cor Sec.16

land from C-24940

land to C-24940

land from C-25990

land to C-25990

C-24940- change in
POD only

RECEIVED

JAN 16 1981

WATER RESOURCES DEPT
SALEM, OREGON