


T.5S. R.IE. W.M.

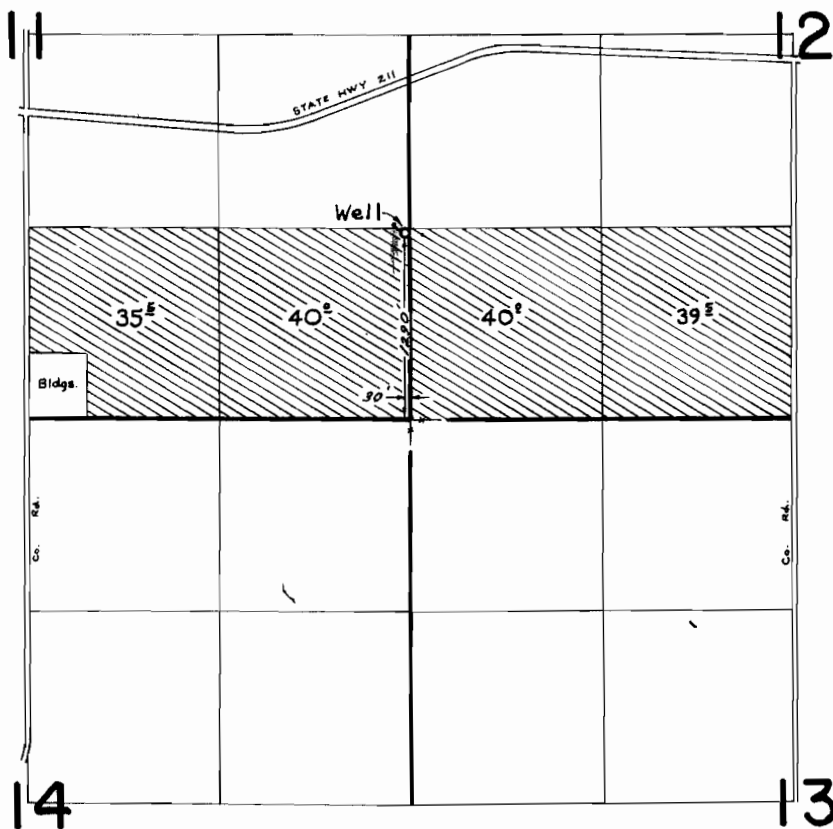

FINAL PROOF SURVEY

UNDER

Application No. G-5514 Permit No. G-4846
IN NAME OF _____

CRESTVIEW FARMS INC.

Surveyed JULY 16, 1974, by L.E. GOULD