


T. 13S., R. 33E., W. M.

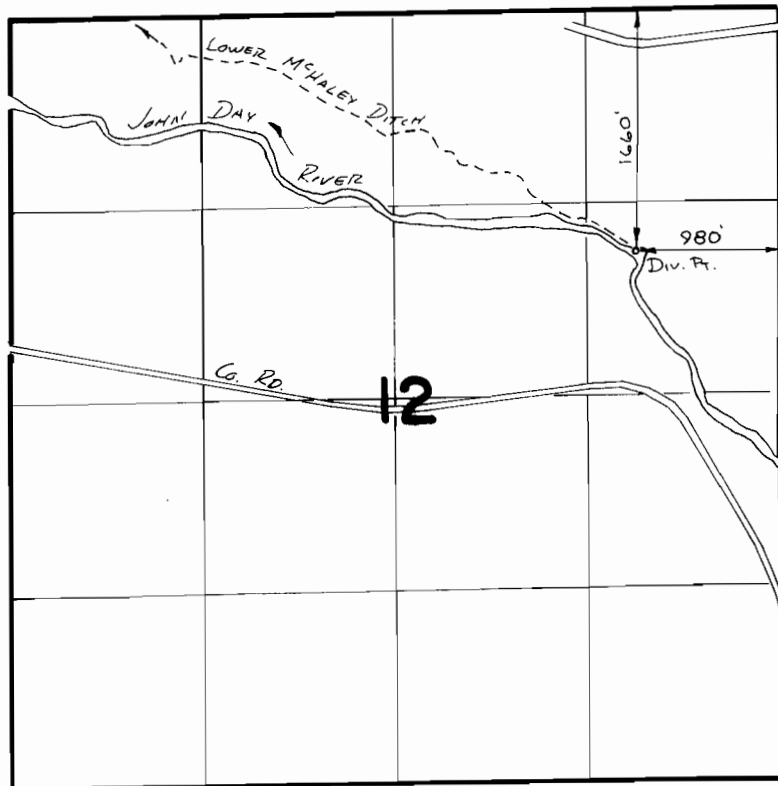

SCALE 1" = 1320'

FINAL PROOF SURVEY

UNDER

TRANSFER 4791

IN NAME OF

.....**JOHN FORREST**.....


Surveyed ..3..19..... 19.86., by L. Tall.....

T. 13 S., R. 33 E., W.M.

T-4791

TRANSFER APPLICATION MAP FOR

JOHN FORREST

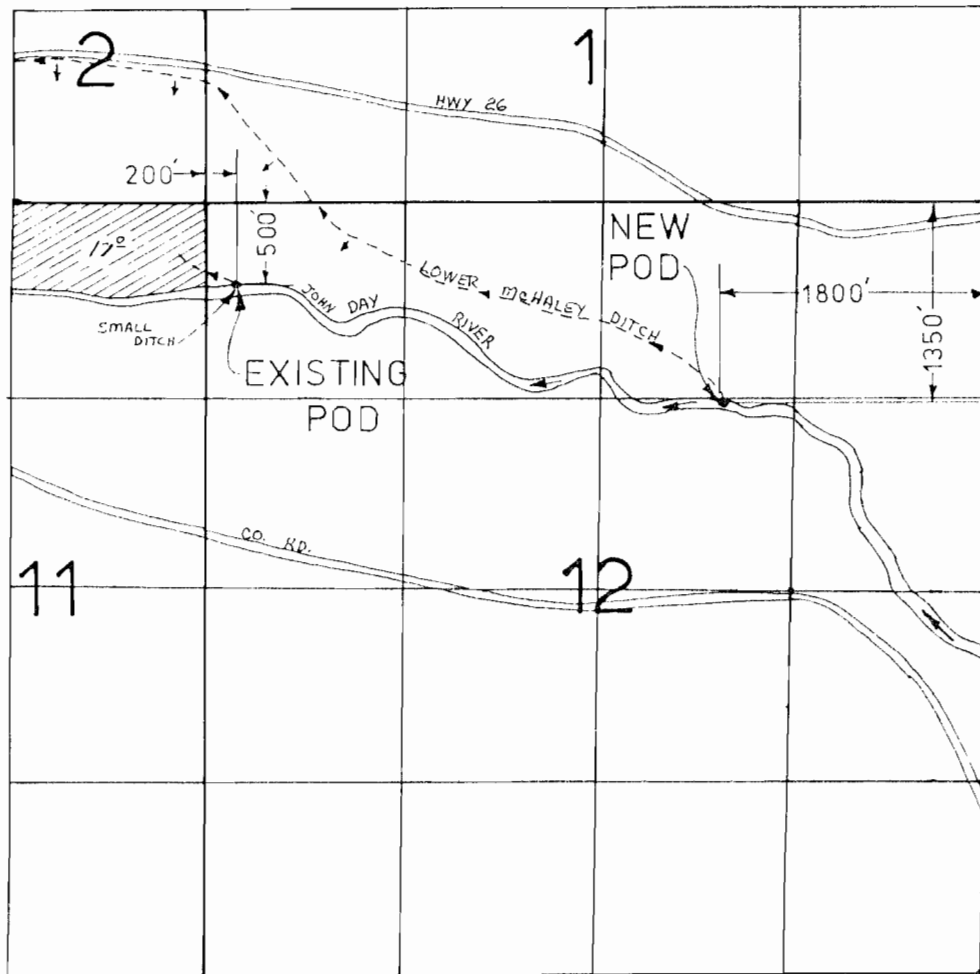

APPROVED _____

RECEIVED
JUN 19 1901
WATER RESOURCES DEPT
SALEM, OREGON