


T. 9 S., R. 26 & 27 E., W.M.

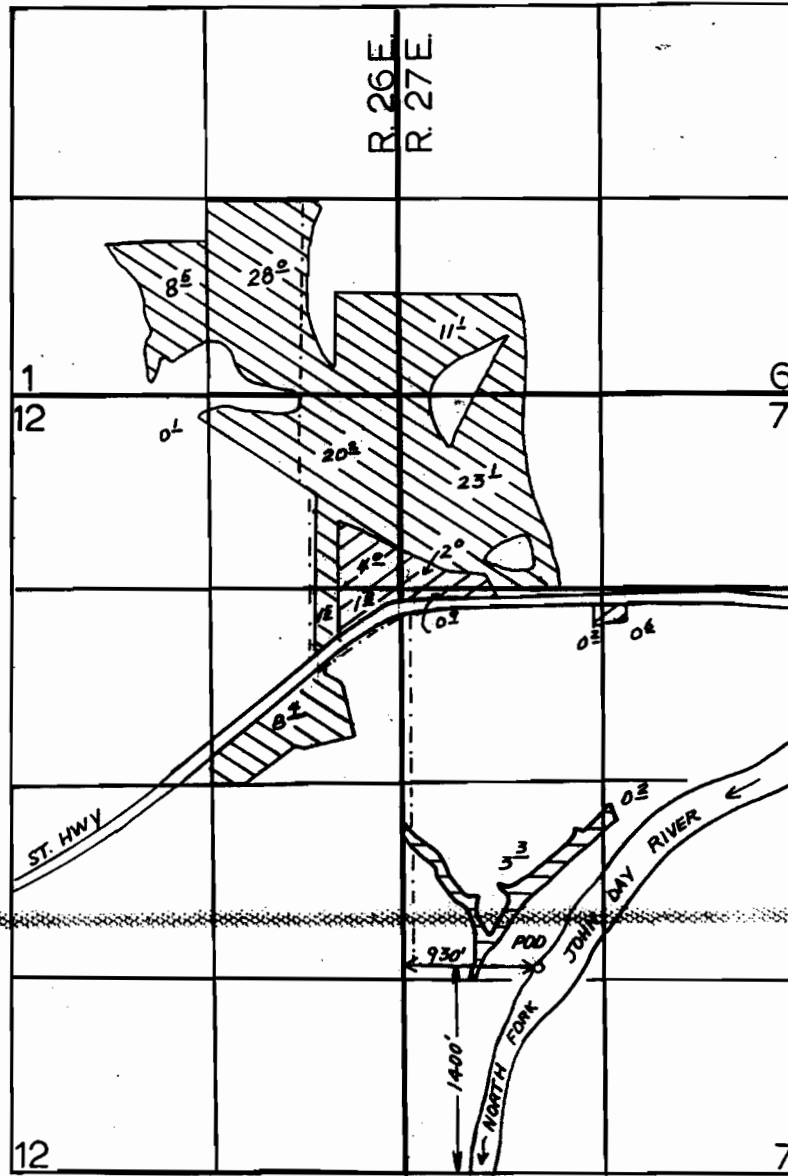

1" = 1320'

FINAL PROOF SURVEY

UNDER

Application No. 53123 Permit No. 38601
 65083 47568

IN NAME OF

STEVEN HOLMES

Surveyed 8-1, 1991, by J. MILLER

P# 38601



P# 47568
PRIMARY



P# 47568
SUPPL'M

