


T. 9 S., R. 26 E., W.M.

RECEIVED

12 1 1997

NATURAL RESOURCES DEPT.
SALTMAR, OREGON

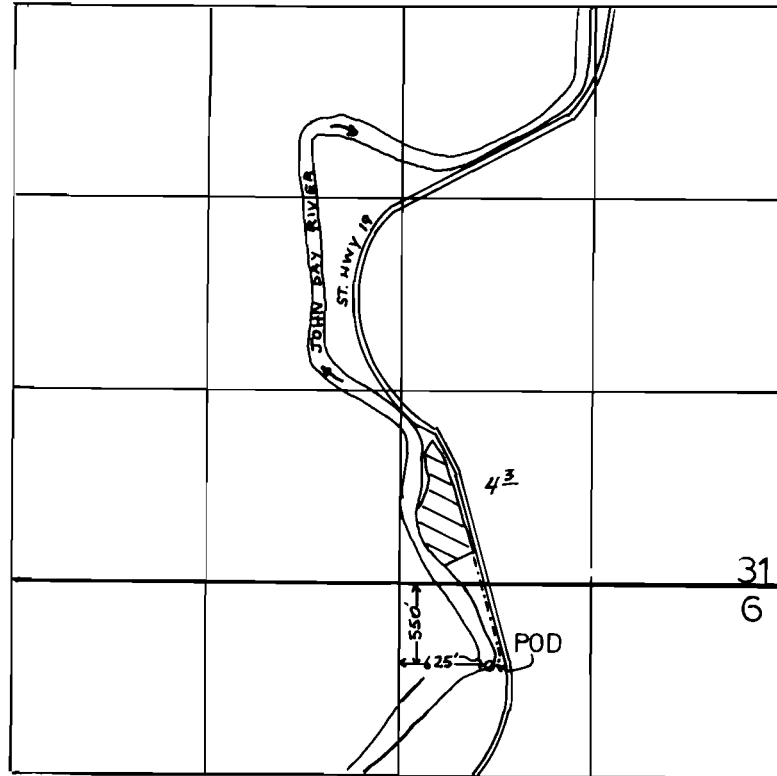

1" = 1320'

FINAL PROOF SURVEY

UNDER

Application No. 53936 Permit No. 40602
IN NAME OF

CARL R. SLAUGHTER

Surveyed August 26, 1992, by J. Miller