


T. 7 S., R. 29 E., W.M.

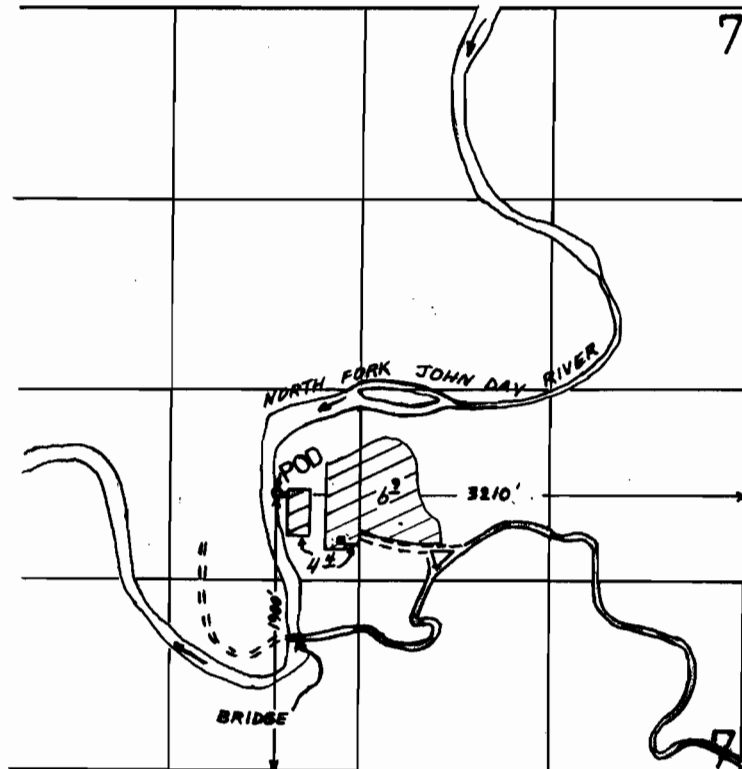

↑
N
1" = 1320'

RECEIVED

MAY - 2 1996

WATER RESOURCES DEPT.
SALEM, OREGON

FINAL PROOF SURVEY

UNDER

Application No. 65888 Permit No. 48026
IN NAME OF

JACK H. AND ELLEN A. HARTMAN

Surveyed SEPTEMBER 30, 1994, by J. MILLER