

TOWNSHIP 11 SOUTH, RANGE 23 EAST, W.M.

RECEIVED

DEC 2 6 2002

WATER RESOURCES DEPT.
SALEM, OREGON



1" = 1320'


FINAL PROOF SURVEY UNDER

Application No. 67775 Permit No. 48295

IN THE NAME OF

FOPIANO RANCHES

Surveyed May 17, 2000 by J. Miller

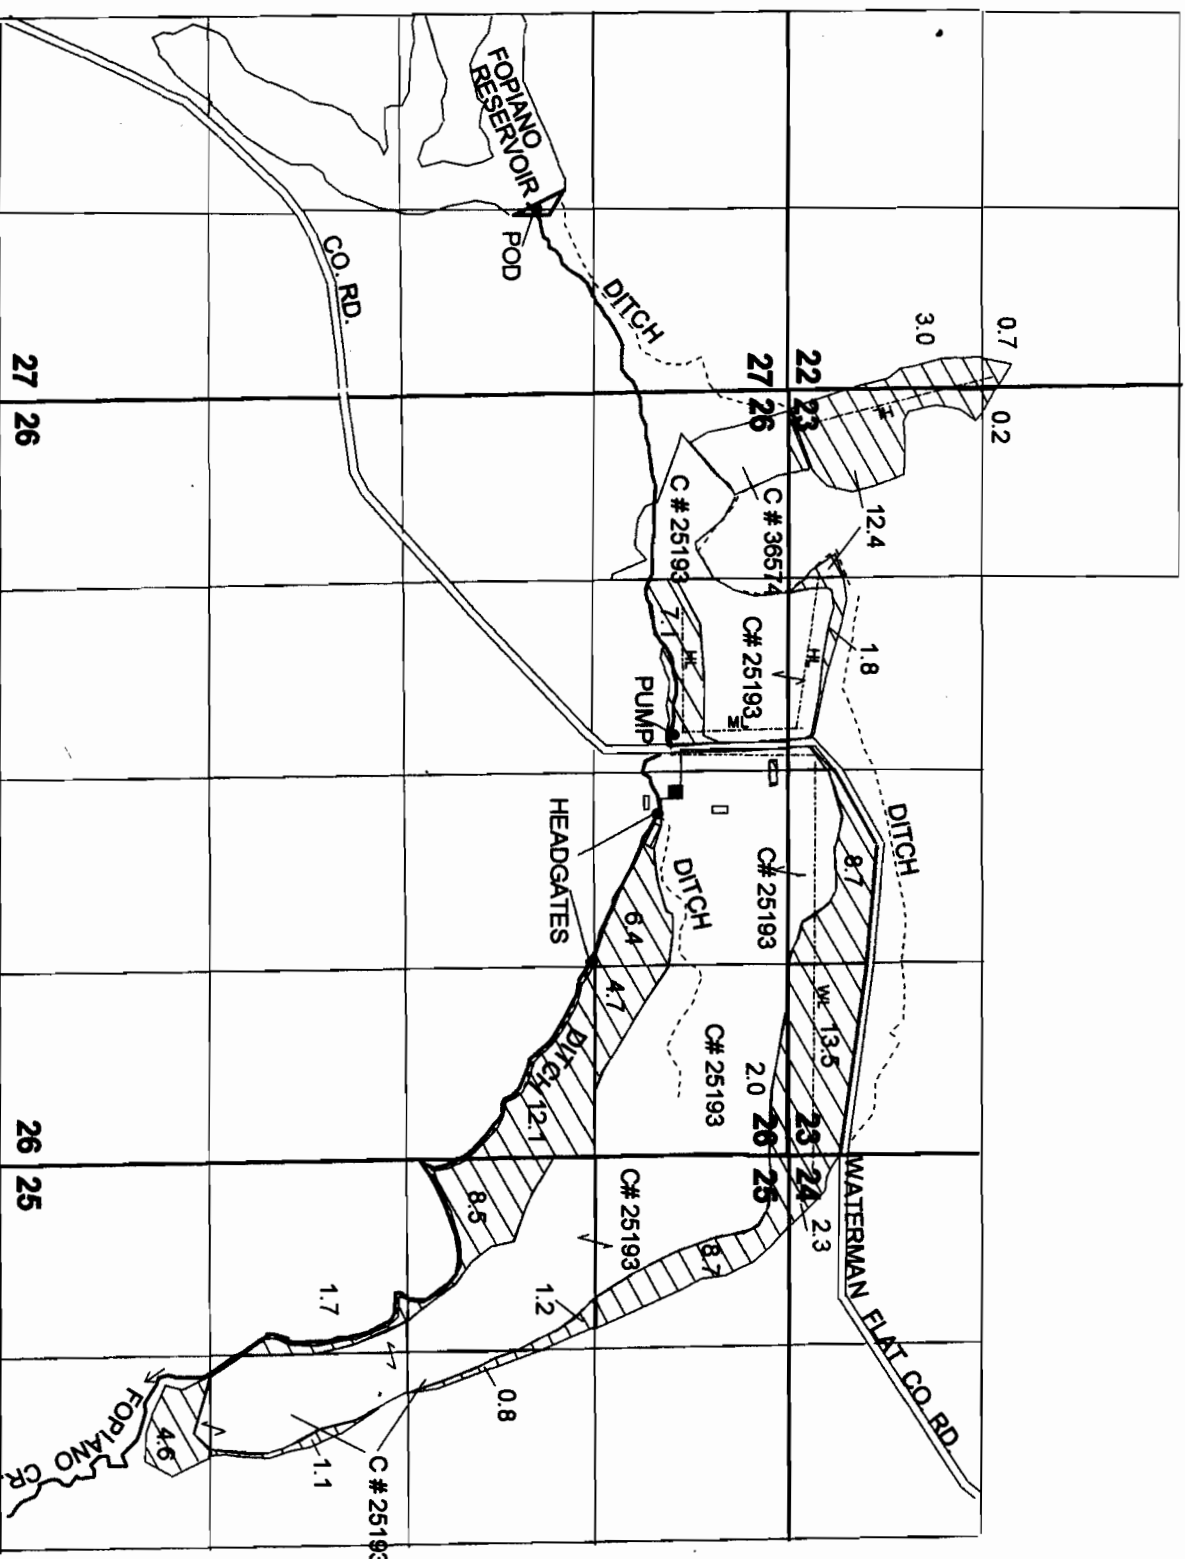

POD - 7030 FEET SOUTH AND 11, 910 FEET WEST FROM THE NORTHEAST CORNER OF SECTION 24.