



T.6N., R.35E., W.M.

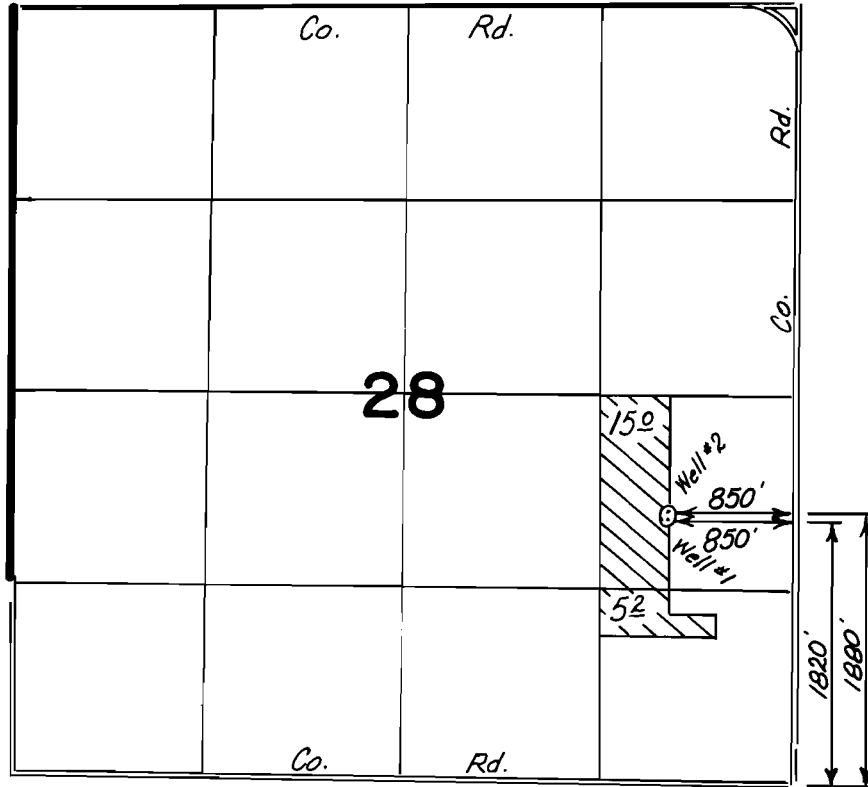

FINAL PROOF SURVEY

UNDER

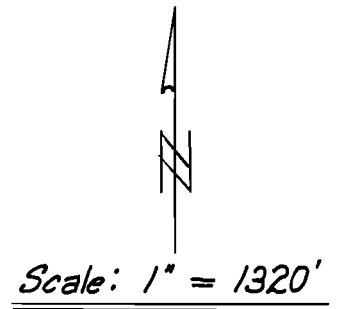

Application No. **G11249** Permit No. **G10441**...
 IN NAME OF

.....**JACK D. SLUSARENKO**.....

Surveyed ...**1-13**... 19**88**., by ...**Vern Church**..