


T. 7 S., R 35 1/2 E., W. M.

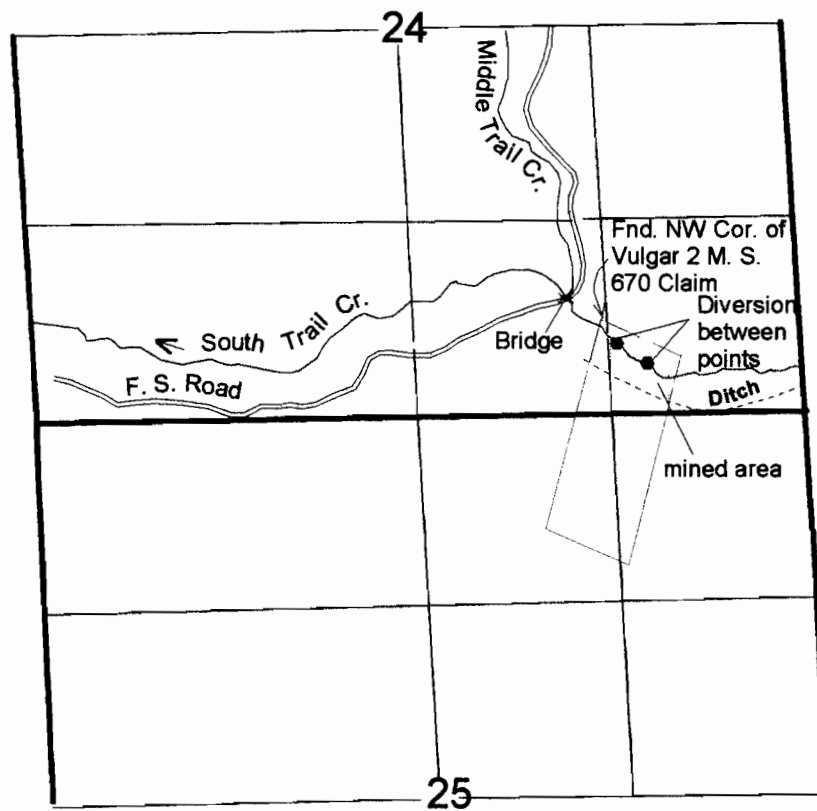

DIVERSION - BETWEEN POINTS 400' N. & 1300' W. AND 600' N. & 1550' W. FROM THE SE CORNER OF SECTION 24.

FINAL PROOF SURVEY

UNDER

Application 37874 Permit 28365

IN THE NAME OF

DAVID H. & LINDA M. SCOTT

Surveyed : July 24, 2000 by: J. Miller

RECEIVED

OCT 30 2002

WATER RESOURCES DEPT
SALEM, OREGON