

APPLICATION MAP



PROPERTY OWNER: JOAN JOY

SITE ADDRESS: 9080 SW OAKLEAF CT
MC MINNVILLE, OR 97128

SECTION 28, T45, R5W, W.M.

TAX LOT #: R4528 01700

LEGAL DESCRIPTION:
LOT 11, BLOCK 6, EAGLE
POINT RANCH, YAMHILL
COUNTY, OREGON

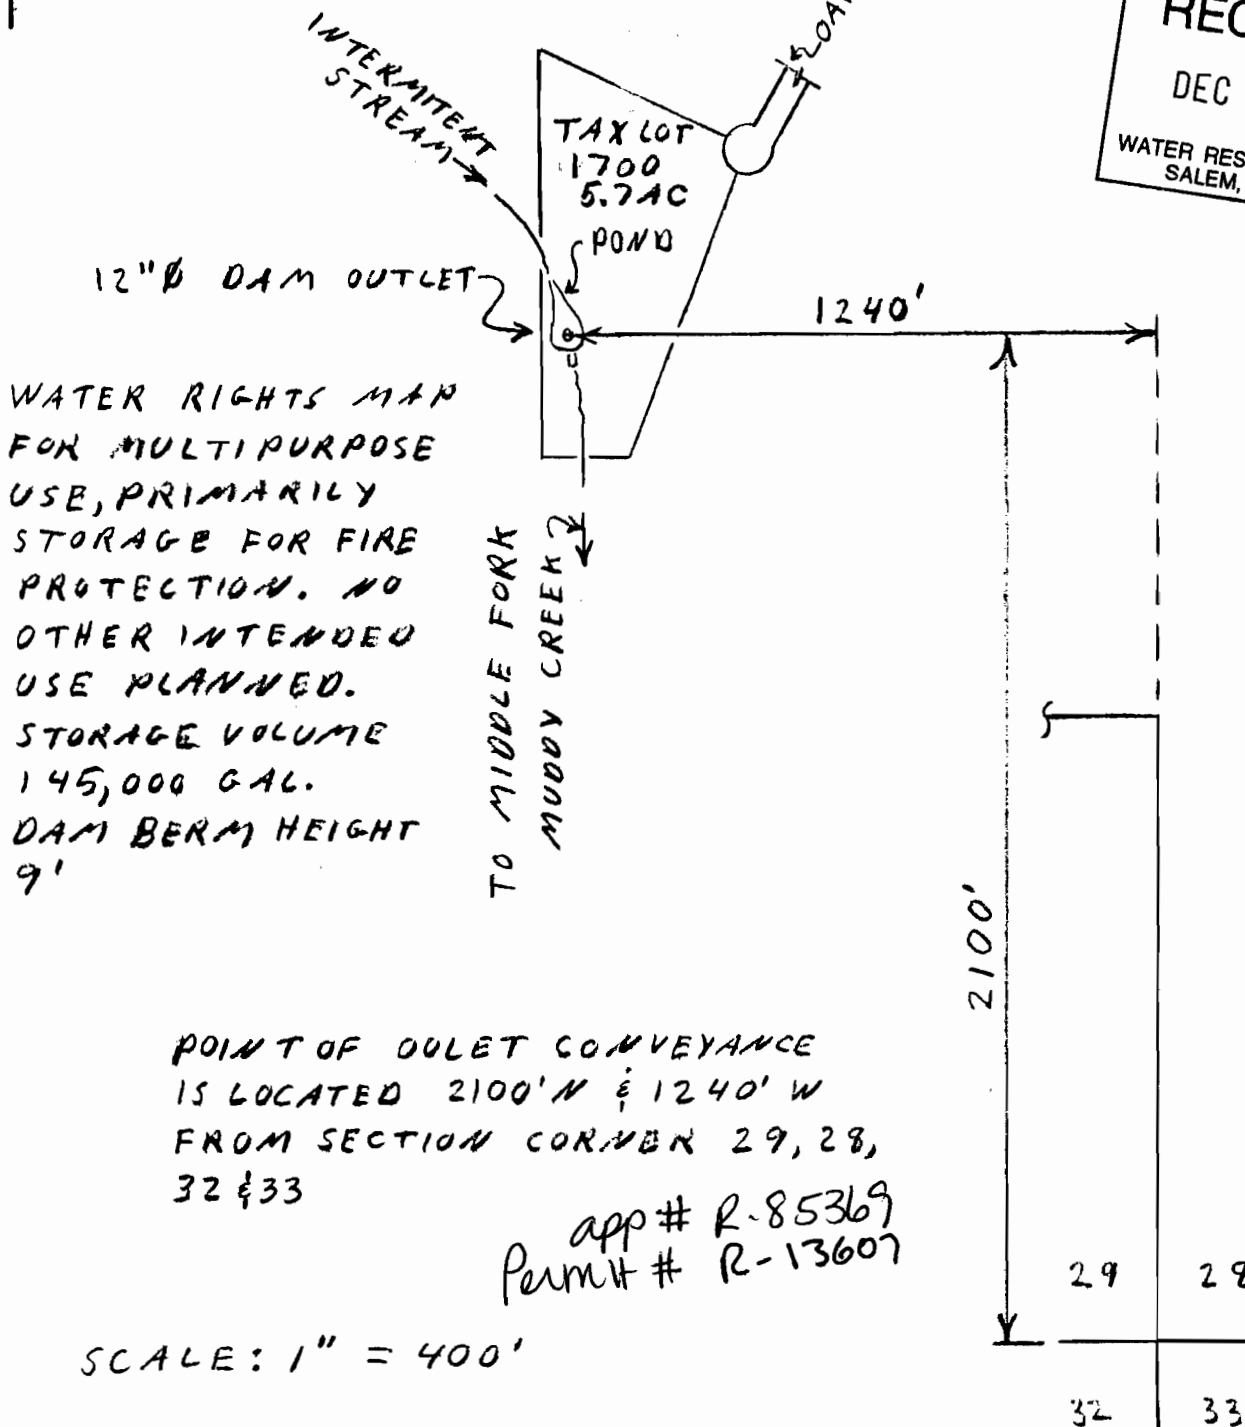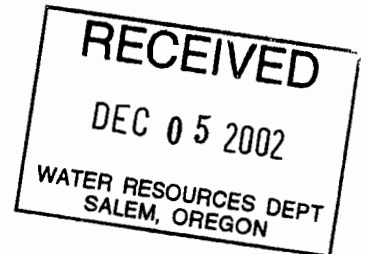

POINT OF OULET CONVEYANCE
IS LOCATED 2100' N & 1240' W
FROM SECTION CORNER 29, 28,
32 & 33

app # R-85369
Permit # R-13607

SCALE: 1" = 400'