


T. 8 S., R. 27 E., W.M.

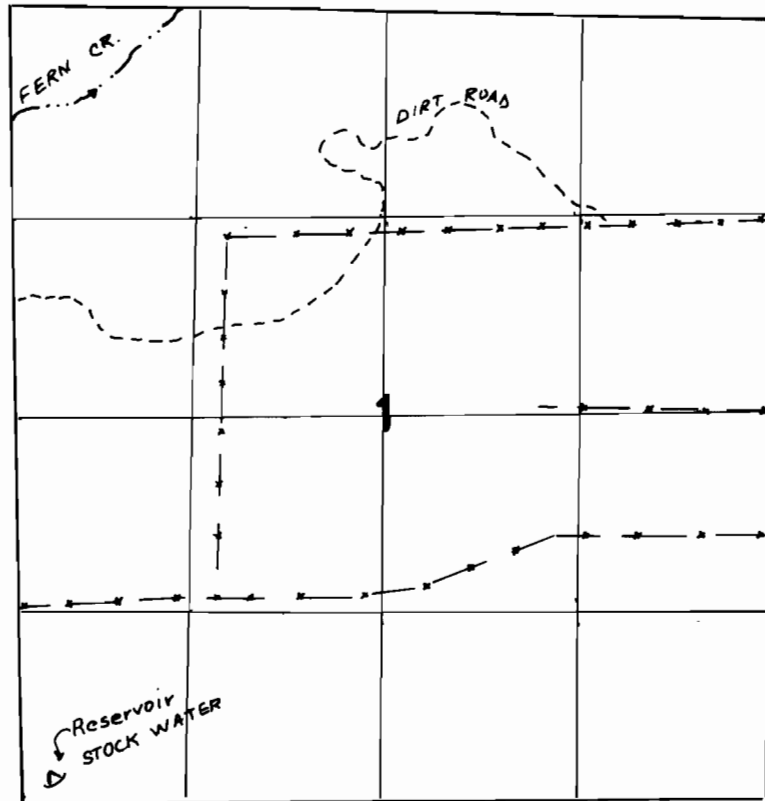

FINAL PROOF SURVEY
UNDER

Application No. R-65972 Permit No. R-9092
IN NAME OF

RALPH GANO MILLER

Surveyed JULY 22, 1994, by J. MILLER

Johnny Cake Mtn. Quad 5-2-96 JM