


T. 7 S., R. 27 E., W.M.

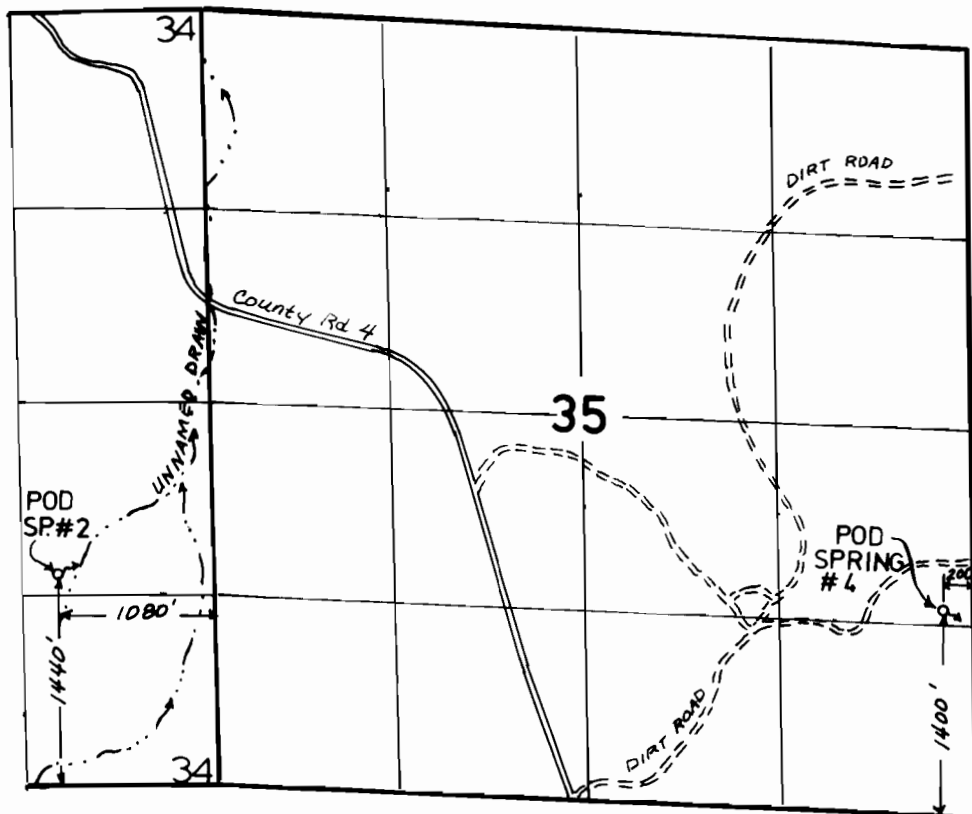

FINAL PROOF SURVEY
UNDER

Application No. 65973 Permit No. 48033
IN NAME OF

RALPH GANO MILLER

Surveyed JULY 22, 1994, by J. MILLER



1" = 1320'