



TOWNSHIP 12 SOUTH, RANGE 20 EAST, W.M.

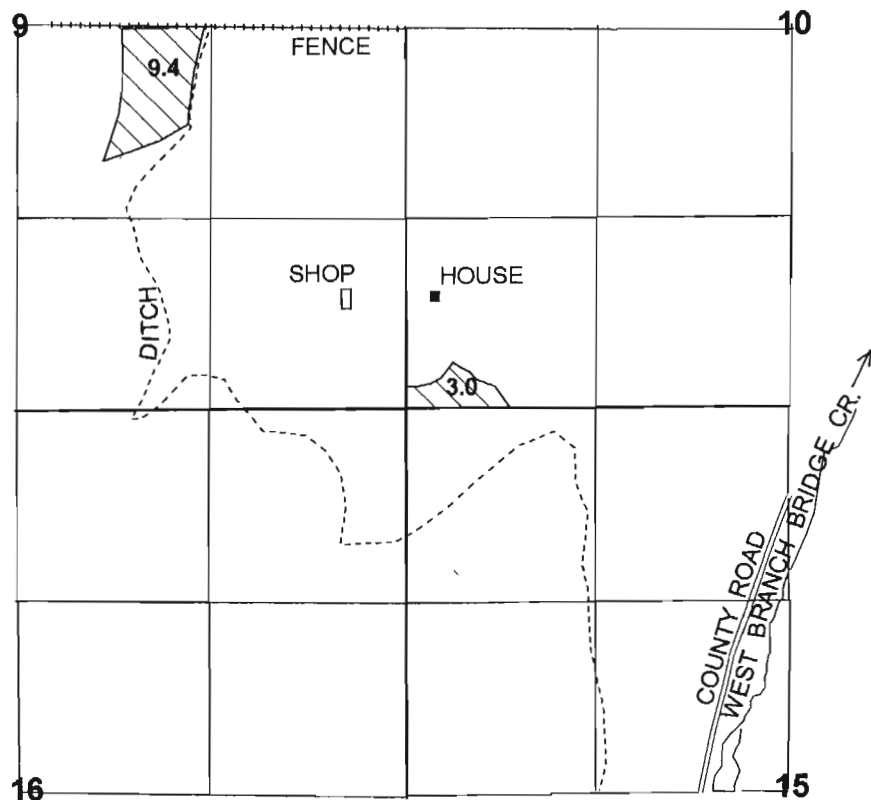

SW 1/4 SECTION 22

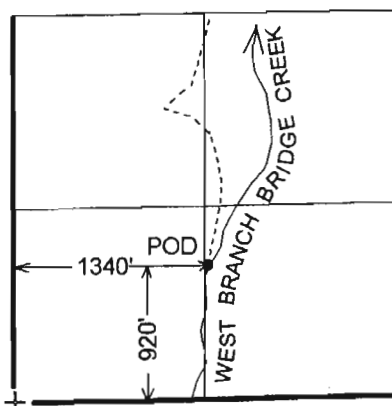

FINAL PROOF SURVEY UNDER

Application No. 66886 Permit No. 48127

IN THE NAME OF
DON B. AND PATRICIA GEER

Surveyed: May 7, 2001 by: J. Miller

RECEIVED

DEC 26 2002

WATER RESOURCES DEPT.
SALEM, OREGON