



T. 13 S., R 34 E., W. M.

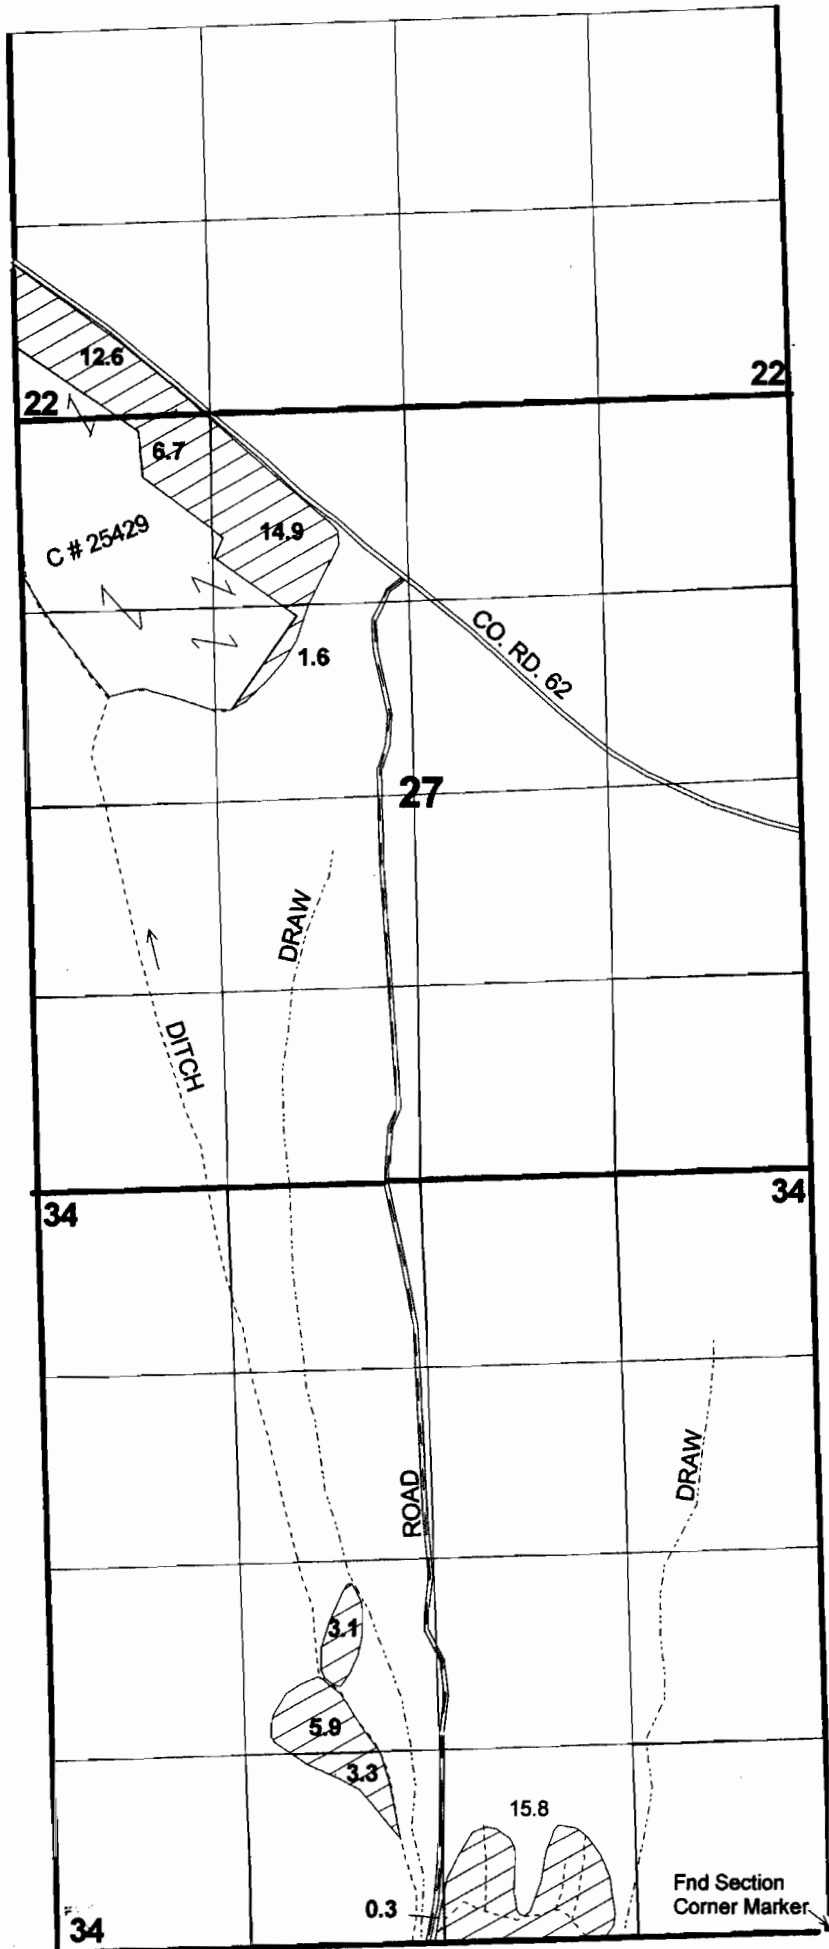

1" = 1320'

T. 14 S., R 34 E.

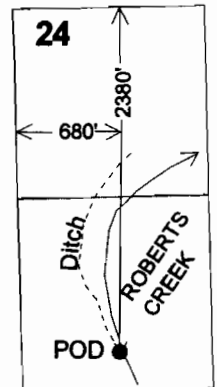

FINAL PFOOF SURVEY
UNDER
Application No. 67097 Permit No. 48144
IN THE NAME OF

Surveyed June 24, 2003 by: J. Miller