


T.8&9S., R.27E., W.M.

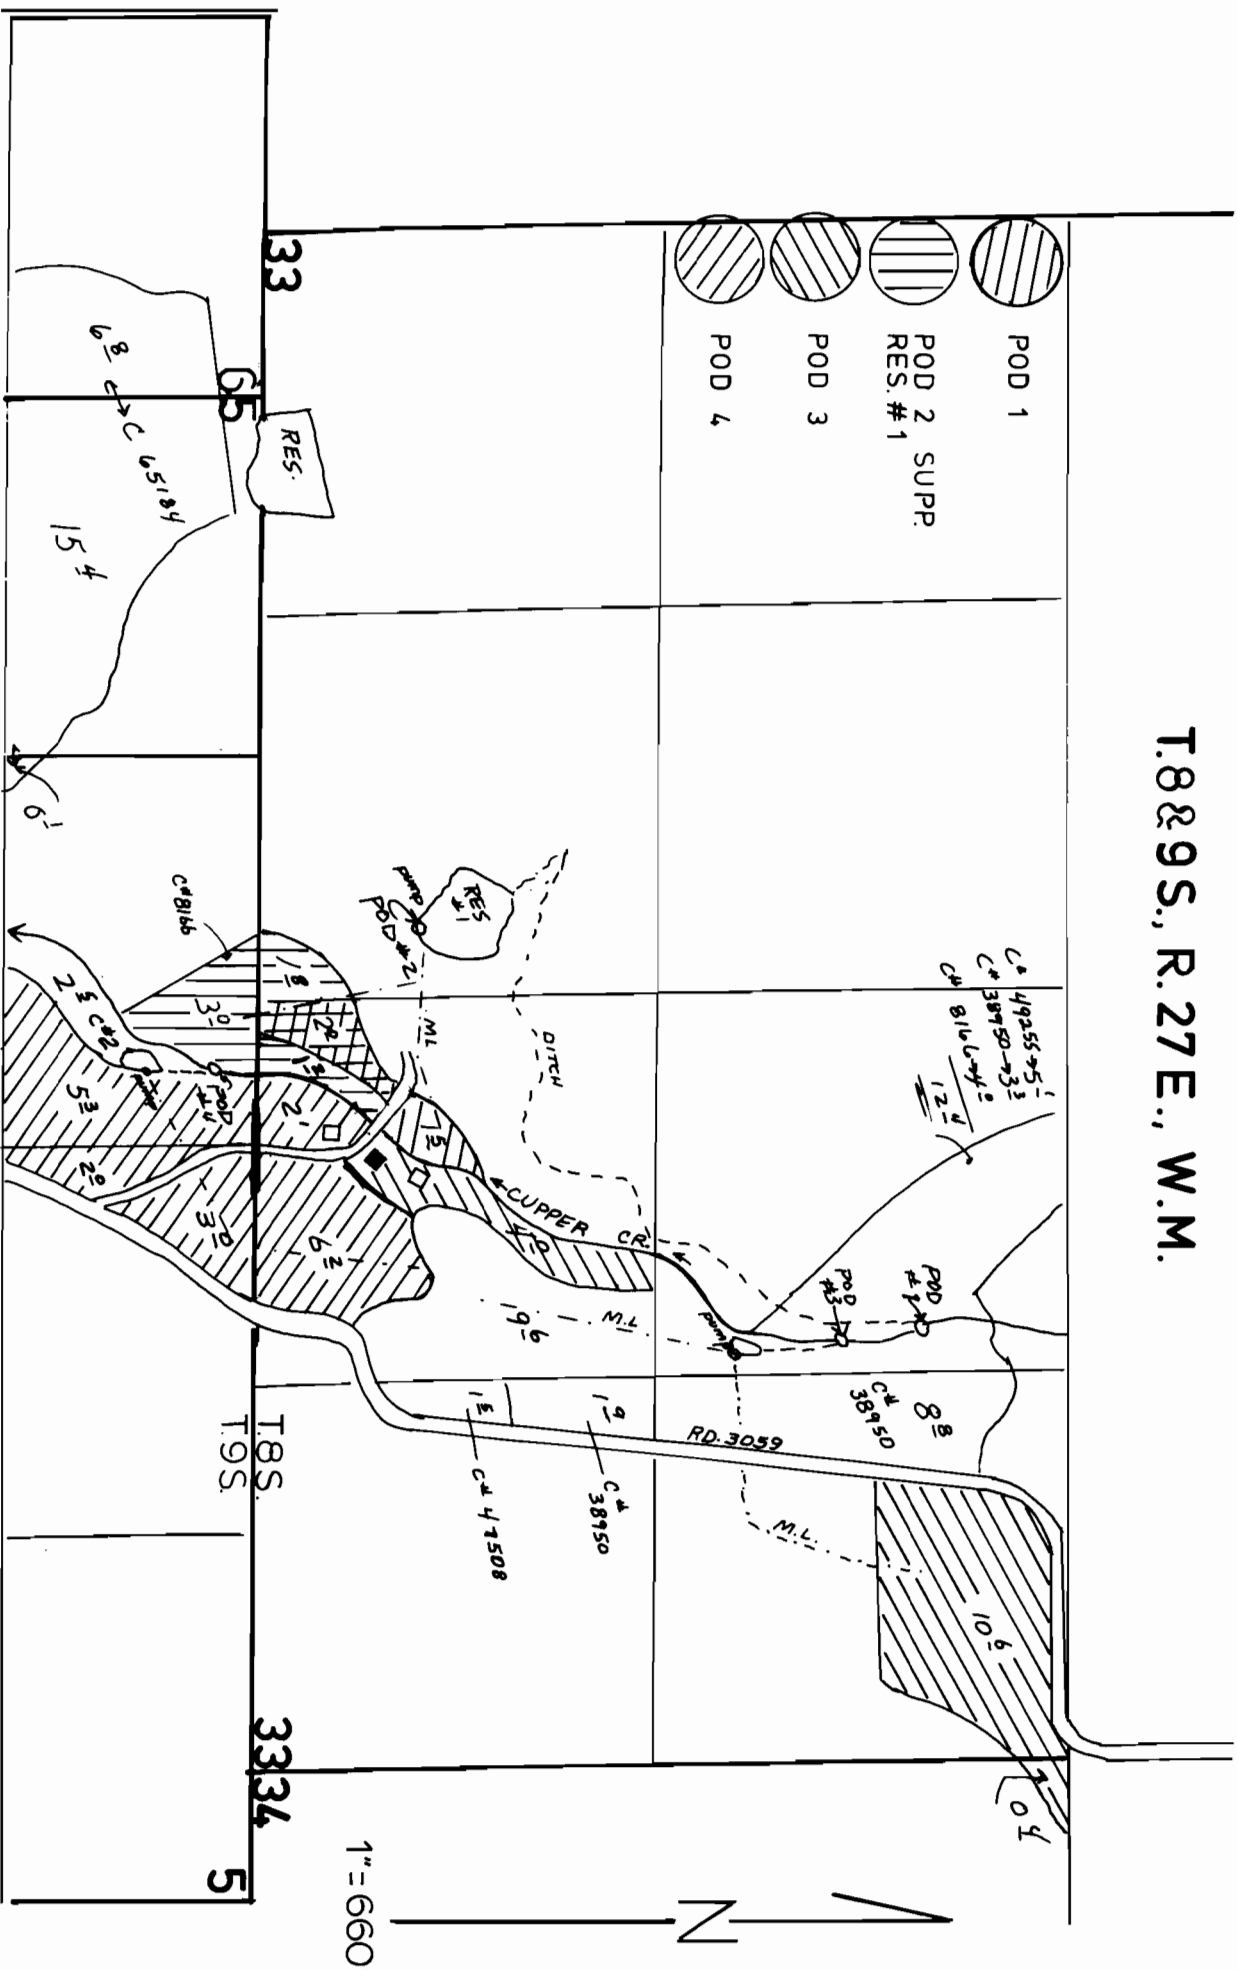

POD 1
POD 2 SUPP.
RES. #1
POD 3
POD 4



POD 1, 2275' N. & 1490' W.
POD 2, 550' N. & 2740' W.
POB 3, 2000' N. & 1450' W.
POD 4, 150' S. & 2425' W.
ALL FROM THE SE CORNER, SEC. 33.

FINAL PROOF SURVEY UNDER

APPLICATION R-67771 PERMIT R9310
67772 48217
IN NAME OF
FRANCIS SHEEDY, ETAL

Surveyed 10-29-1998 § 3-30-2001, J. Miller
41023 179 60R.