
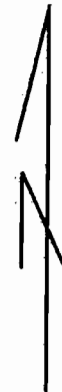


T. 7 S., R. 29 E., W. M.

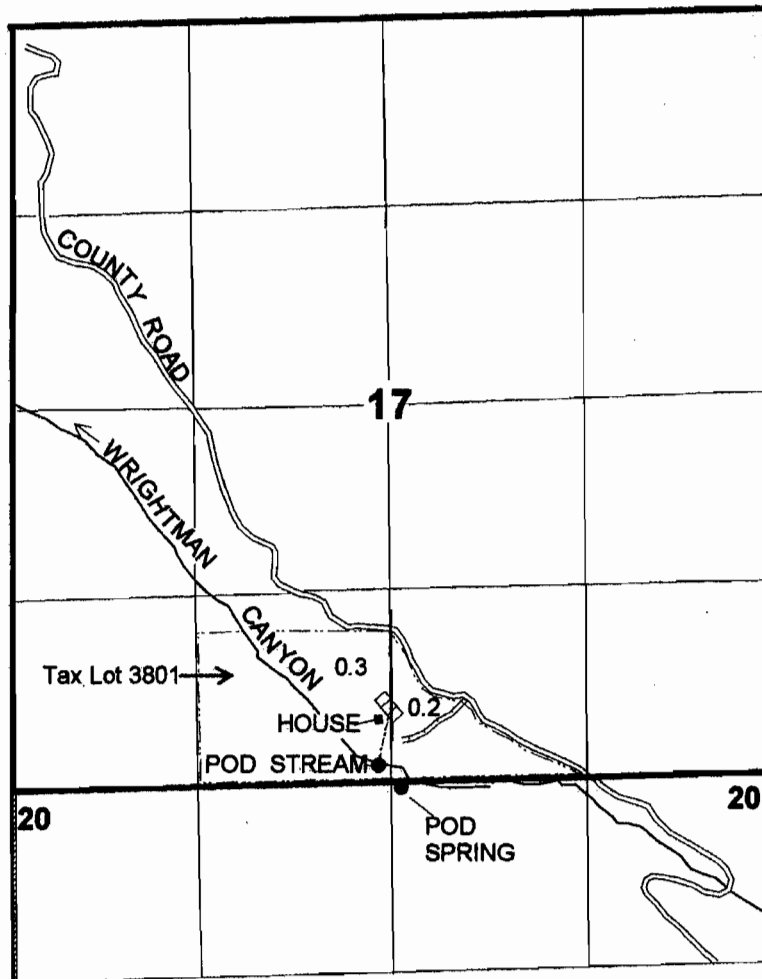

1" = 1320'

POD STREAM 125' NORTH & 100' WEST
POD SPRING 10' SOUTH & 37' EAST,
BOTH FROM THE SOUTH 1/4 CORNER, SECTION 17.

FINAL PROOF SURVEY

UNDER

Application 61330 Permit 45587

IN THE NAME OF

Surveyed: August 30, 2000 by: J. Miller

RECEIVED

OCT 30 2002

**WATER RESOURCES DEPT.
SALEM, OREGON**