


Township 13 South, Range 29 East, W.M.

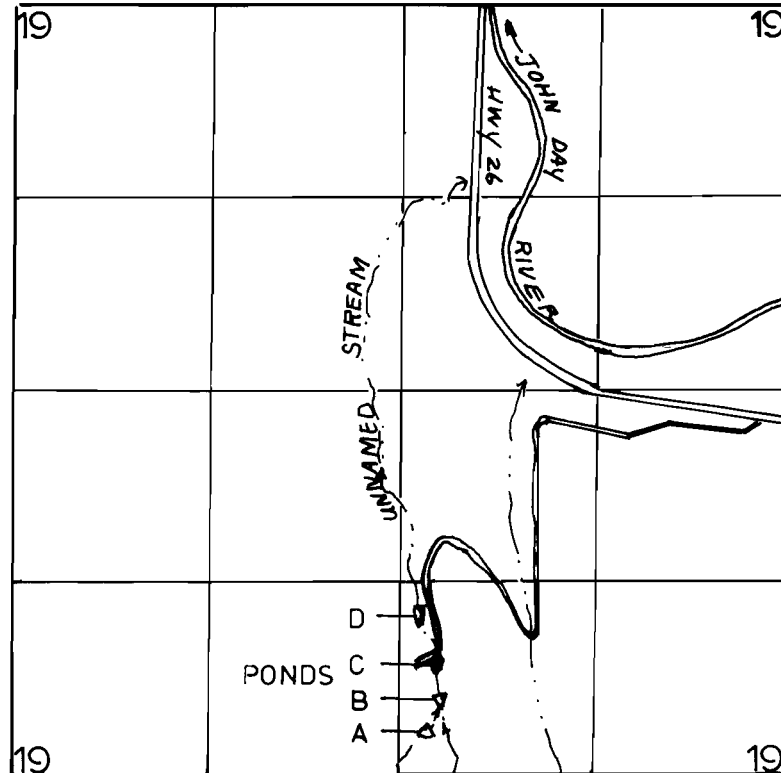

POND A - 300' N. 220' E.
B - 530' N. 260' E.
C - 780' N. 280' E.
D - 1150' N. 125' E. } ALL FROM S. COR. SEC. 19.

FINAL PROOF SURVEY UNDER

Application No. R.66273 Permit No. R.9097.....
IN NAME OF

..... VIRGIL K. FOSTER

Surveyed *Sept. 17* 19*98*, by *J. Miller*.....