


Township 10 S., Range 31 E., W.M.

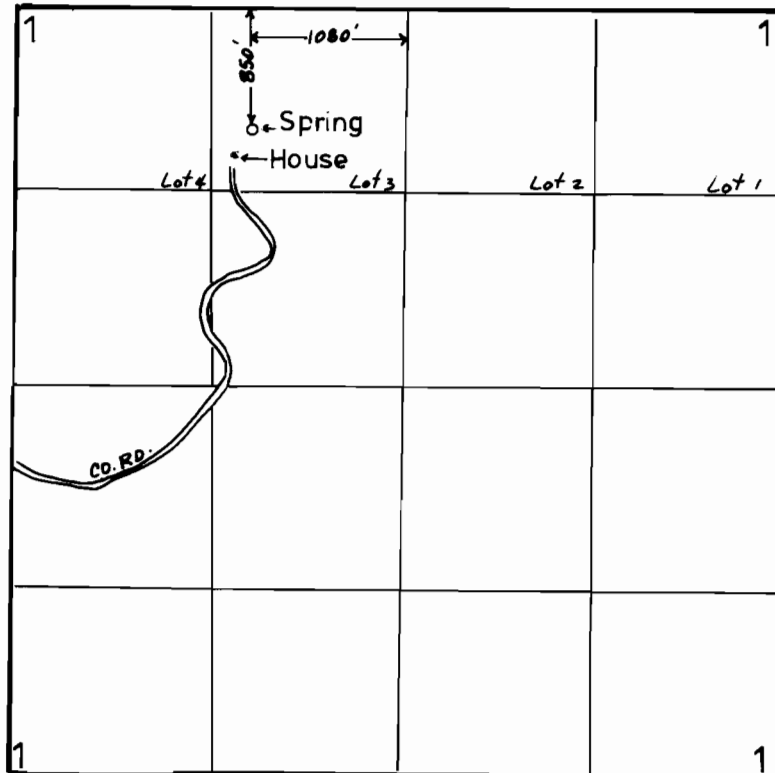

1"= 1320'

**FINAL PROOF SURVEY
UNDER**

Application No. 59280 Permit No. 44606
IN NAME OF

.....
Aug. 5 99 J. Miller
Surveyed 19....., by

Keeney Point 7 1/2' Quad Map 1-5-2000 JM