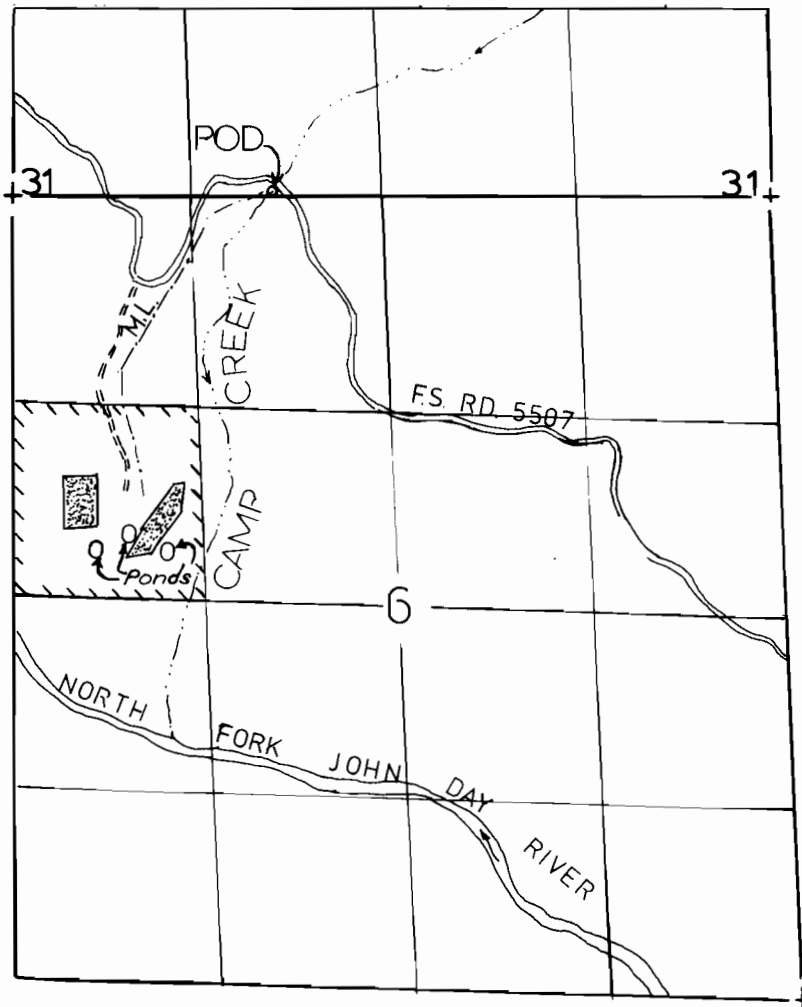


T. 7 S., R. 33 E., W.M.


$$1'' = 1320'$$

POD - SE 1/4 SW 1/4, SEC. 31, T.6 S., R.33 E., W.M., 40' N. & 1775' E.
FROM THE S.W. COR. SEC. 31.

MINING BDRY

AREA MINED

FINAL PROOF SURVEY

UNDER

Application No. 39312 Permit No. 31277
IN NAME OF

DAVID THOMAS

Surveyed October 27, 1994, by J. Miller