


T. 13 S., R. 33 E., W.M.

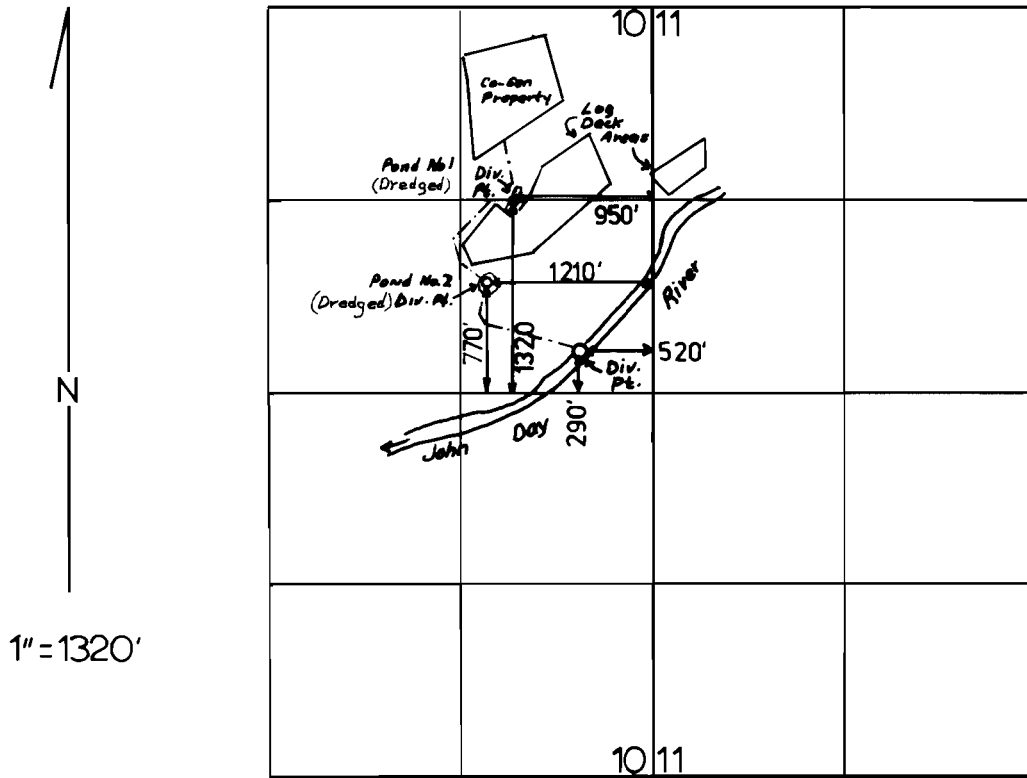

FINAL PROOF SURVEY

UNDER

Application No. G-11525
68787

Permit No. G-10637
49760

IN NAME OF

PRAIRIE WOOD PRODUCTS

Surveyed 11/12, 1991, by J. MILLER