


T.13 S., R. 33 E., W.M.

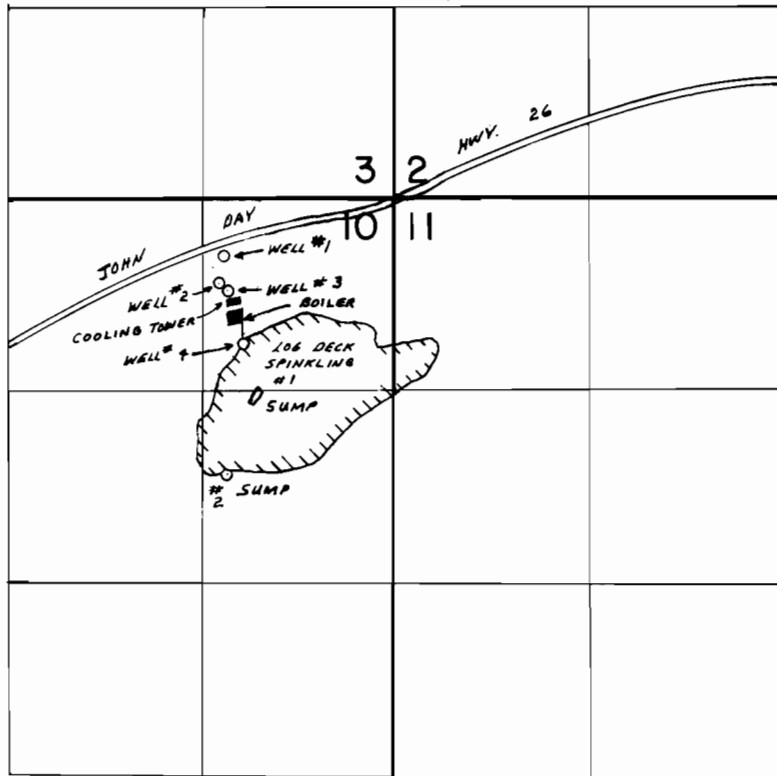

WELL LOC: #1 400' S & 1160' W
 #2 590' S & 1200' W
 #3 630' S & 1190' W ALL FROM THE N.E.
 #4 1000' S & 1040' W COR. SEC. 10
 SUMP LOC: #1 1350' S & 940' W
 #2 1900' S & 1170' W

SCALE: 1"=1320'

FINAL PROOF SURVEY
 UNDER

G-11484 G-10635
 G-11525 G-10637
 Application No. G-11635 Permit No. G-10752...
 IN NAME OF

.....**CO-GEN COMPANY**.....

Surveyed JUL 6 1987, by V.L. CHURCH.....
 OCT. 13 1987

7/27/89

L.C.