


Sec. 4
Tp 21
R. 9E

8017

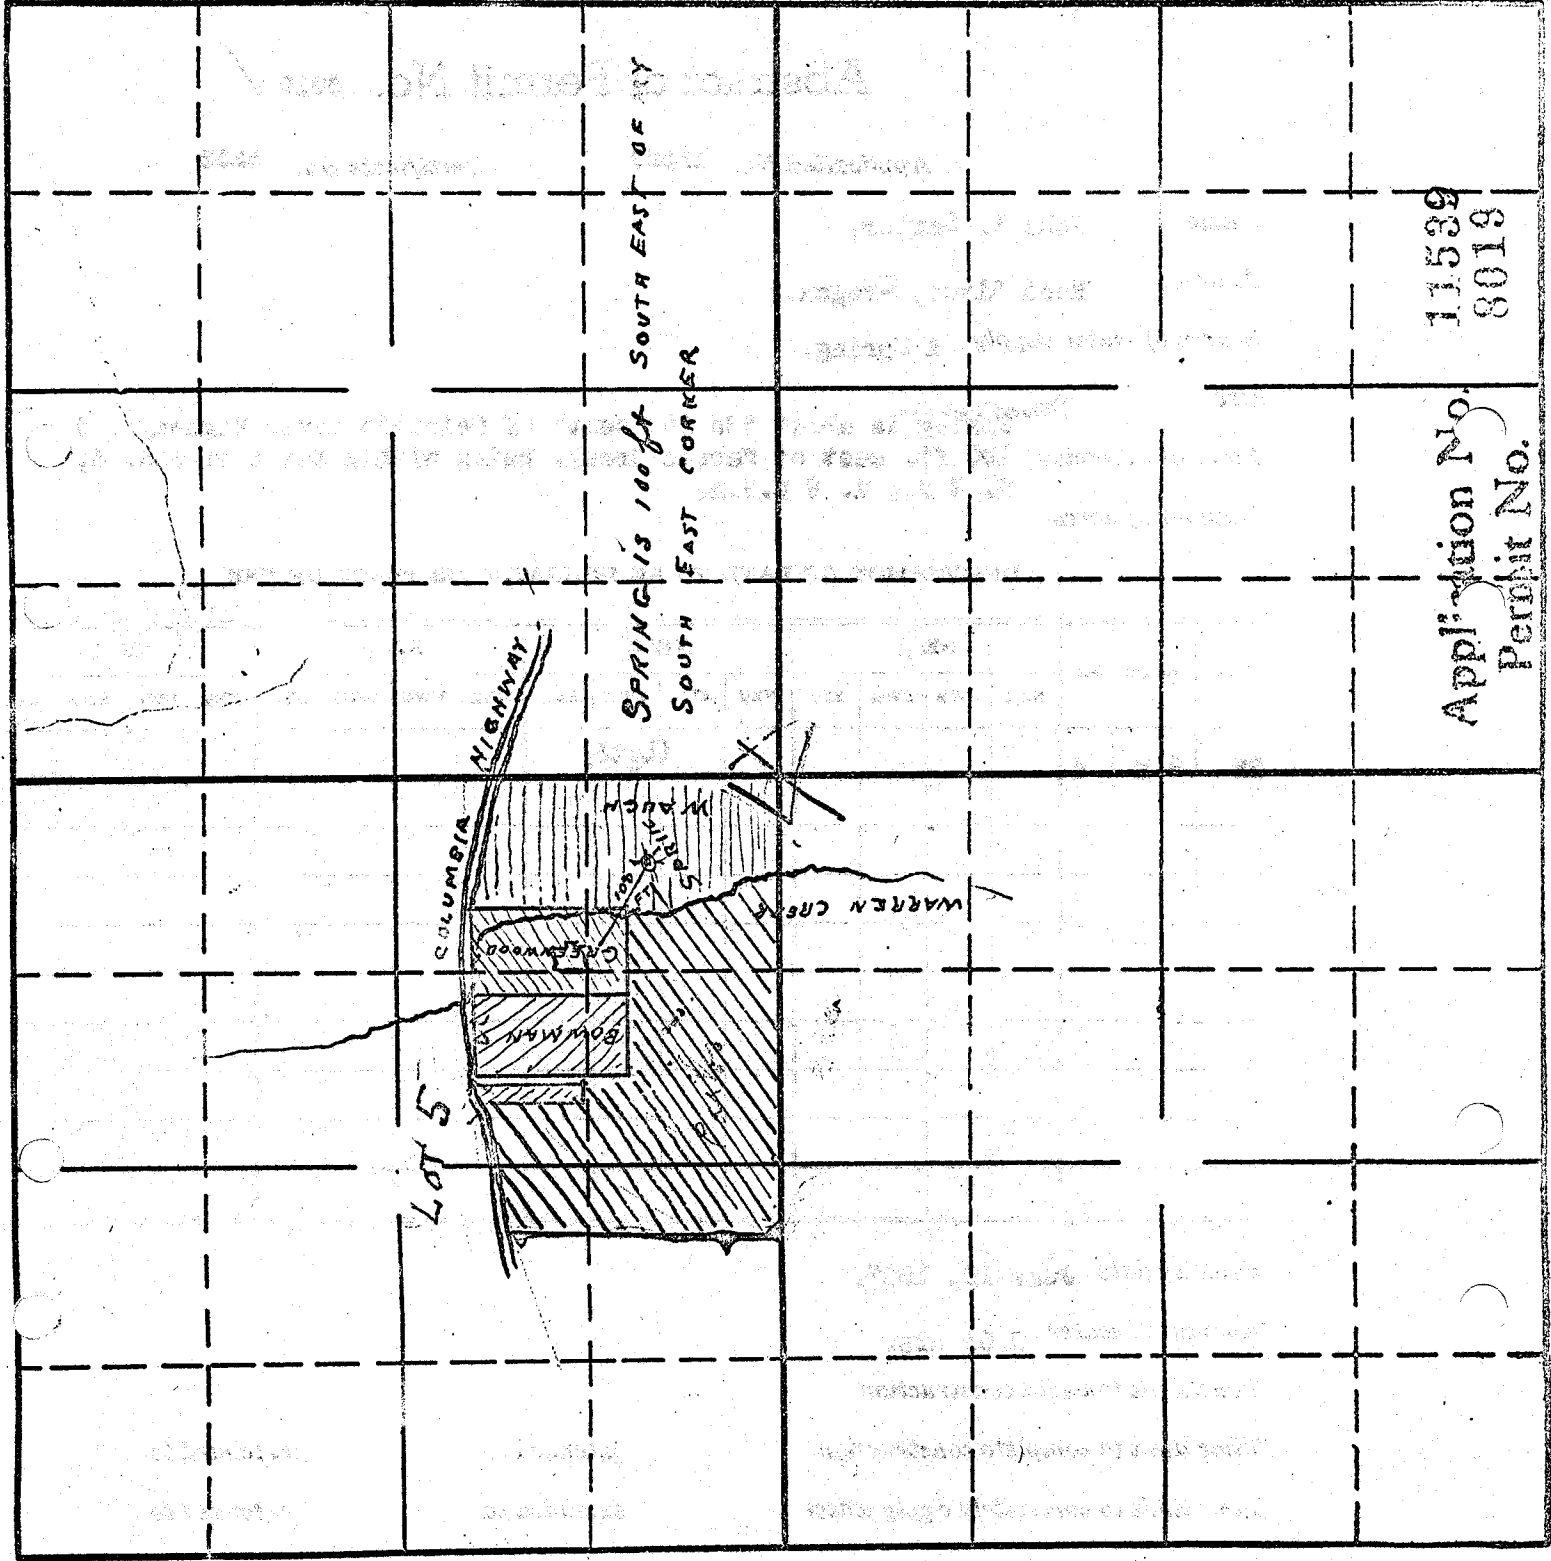

Application No. 11539
