


RECEIVED

MAY 19 1993

WATER RESOURCES DEPT.
SALEM, OREGON

T13S, R33E, W.M.

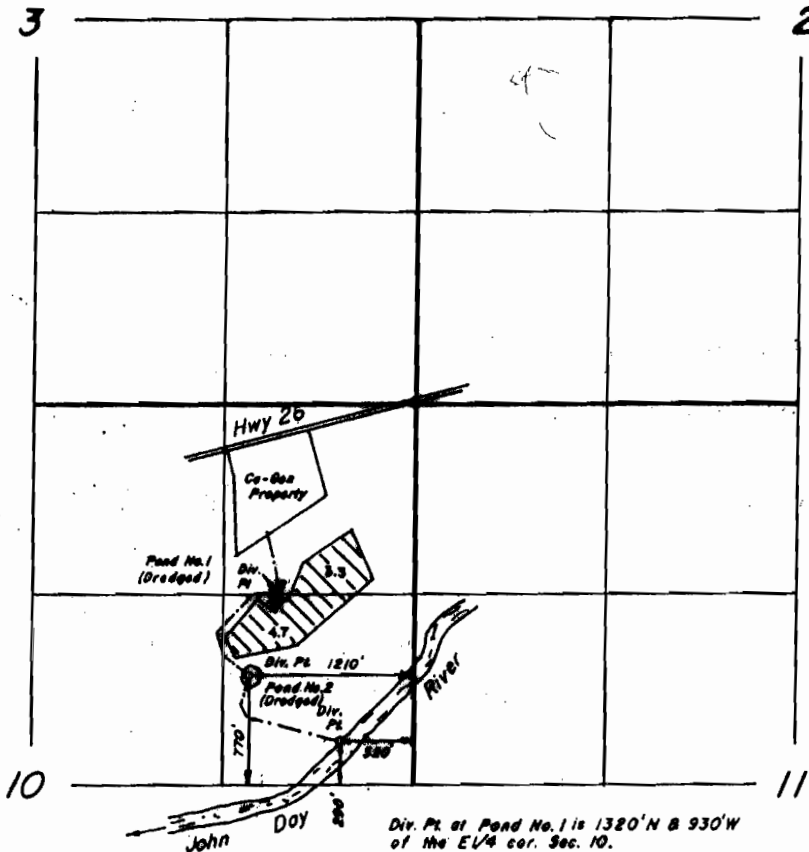

FINAL PROOF SURVEY
UNDER


Transfer No. 6113

Application No. G-11525 Permit No. G-10637


IN NAME OF

Co-Gen Co. & Prairie Wood Products
Don R. Johnson, General Manager

Surveyed Sept 28, 1989. By Robert D. Bayart
Revised July 30, 1992

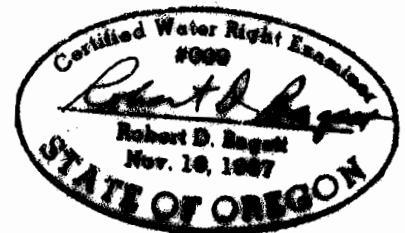

T. 13 S., R. 33 E., W.M.

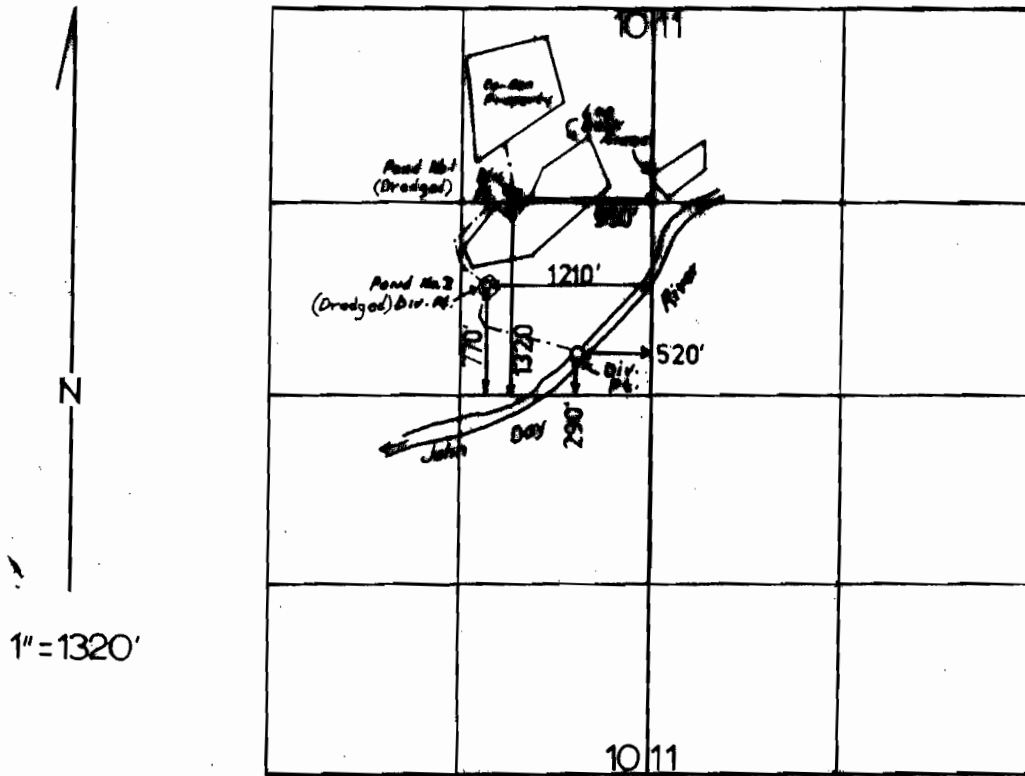

FINAL PROOF SURVEY

UNDER

Application No. G-11525
68787

Permit No. G-10637
49760

IN NAME OF

PRAIRIE WOOD PRODUCTS

Surveyed 11/12, 1991, by J. MILLER