


T.2N.,R.12E.,W.M.

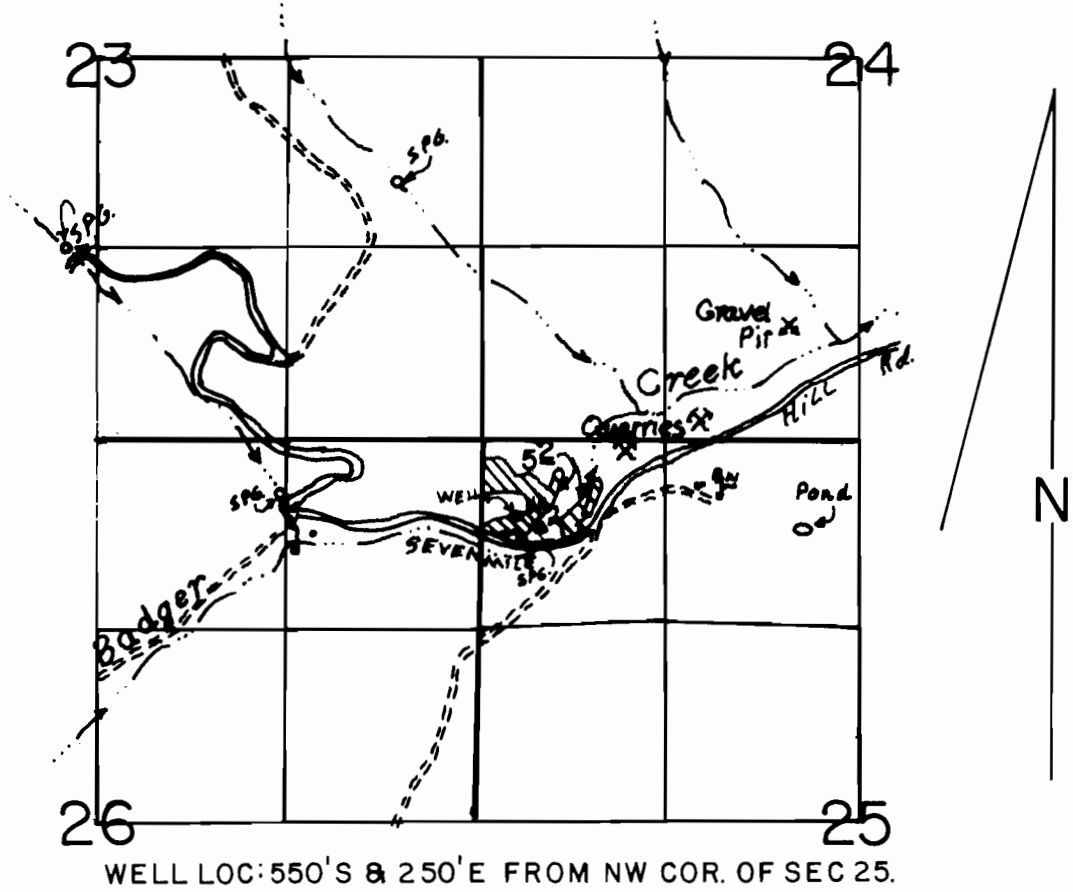

SCALE 1" = 1320'

**FINAL PROOF SURVEY**  
**UNDER**

Application No. G-8258 Permit No. G-7805.....  
**IN NAME OF**

.....KENNETH I. SAUTER.....

**Surveyed** APRIL 26 19.95, by R.M.SUTTERFIELD