




DCY-11H-94 1964-P

T. 16 S., R. 18 E., W.M.

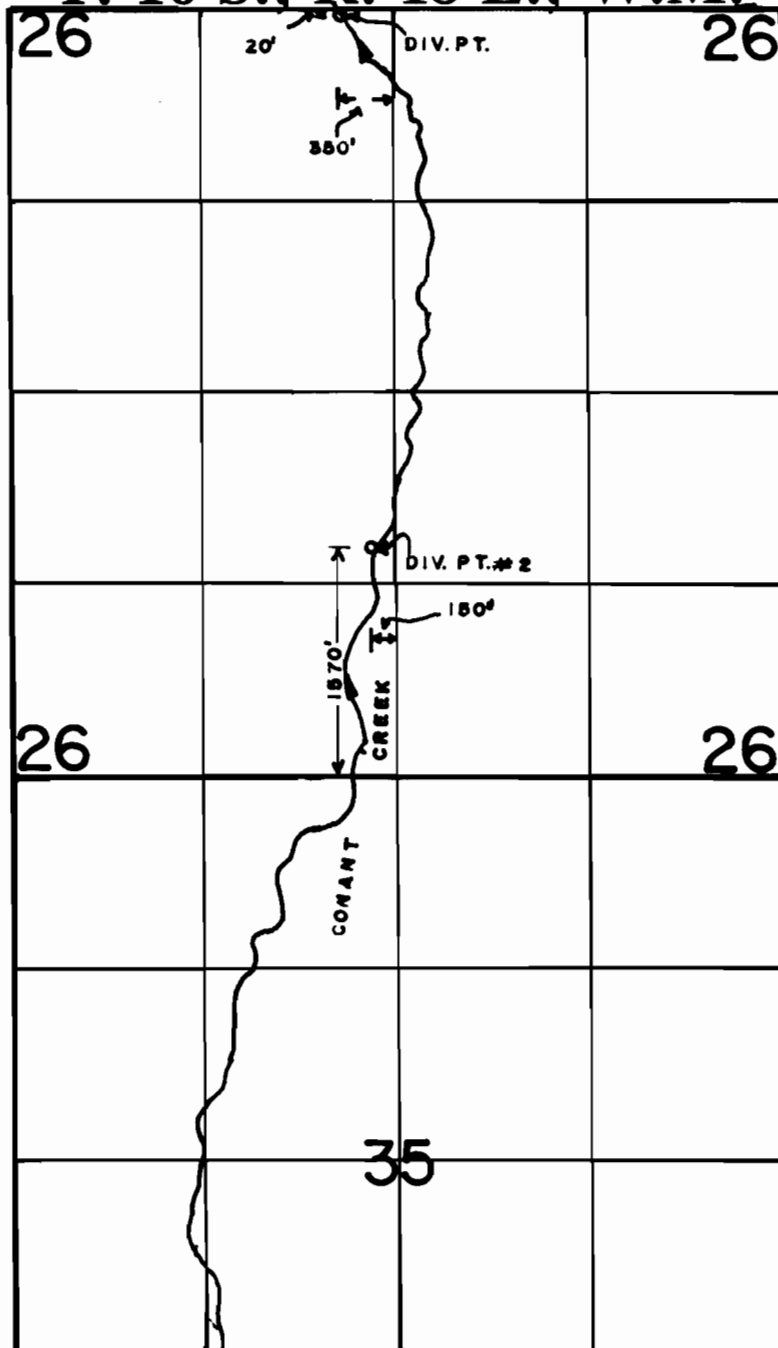

FINAL PROOF SURVEY

UNDER

TRANSFER NO. 3499
IN NAME OF

JOHN & DOLLY BEOLETTO

Surveyed NOV 3, 1992, by R.M.SUTTERFIELD

SCALE: 1"=1320'