



T. 11 & 12 S., R. 21 E., W.M.

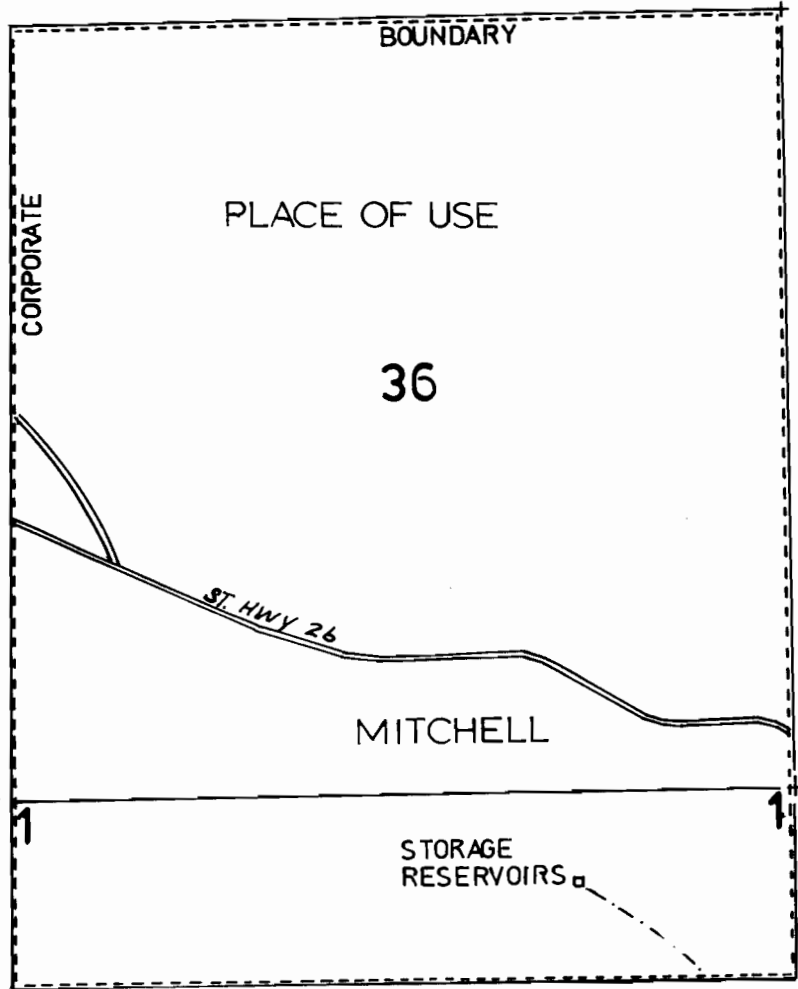

1" = 1320'

DIVERSION

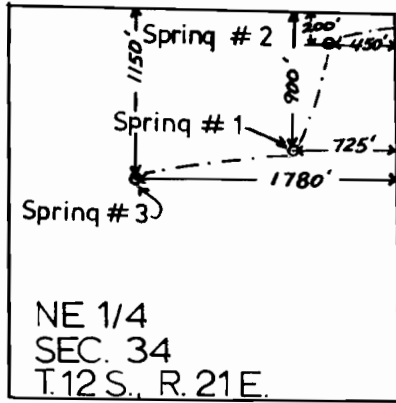

FINAL PROOF SURVEY

UNDER

Application No. 68293 Permit No. 49356
68488 49458
69150 50081

IN NAME OF

CITY OF MITCHELL

Surveyed 4-23, 1992, by J. MILLER