


T. 9 S., R. 23 E., W. M.

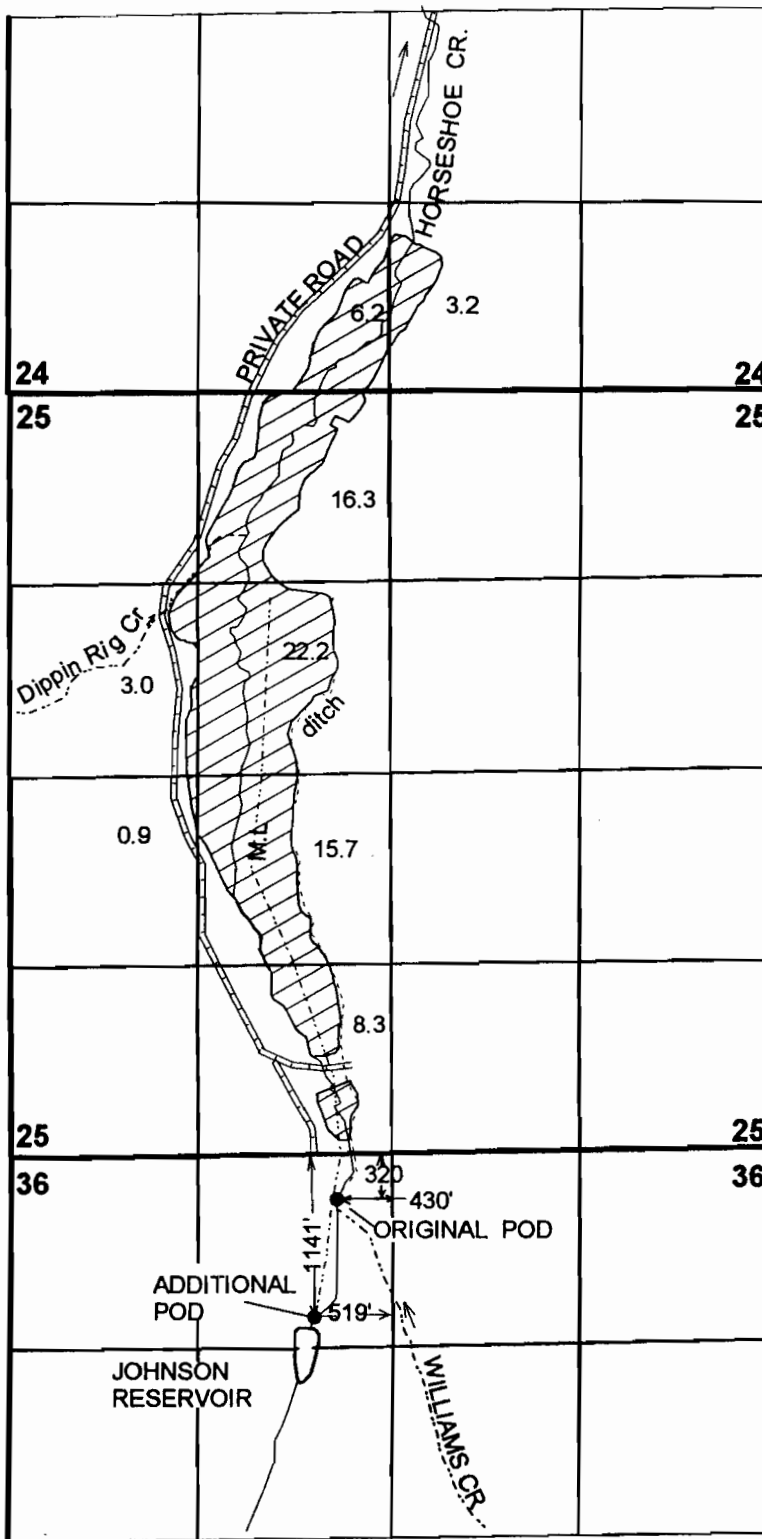

1" = 1320'

**FINAL PROOF SURVEY
UNDER**

Transfer No. 3694

Application No. R- 56024 Permit No. R-6692
56025 42254

IN THE NAME OF
D. R. JOHNSON LUMBER CO.

RECEIVED

OCT 03 2002

WATER RESOURCES DEPT.
SALEM, OREGON