


T. 28S., R. 7 W., W.M.

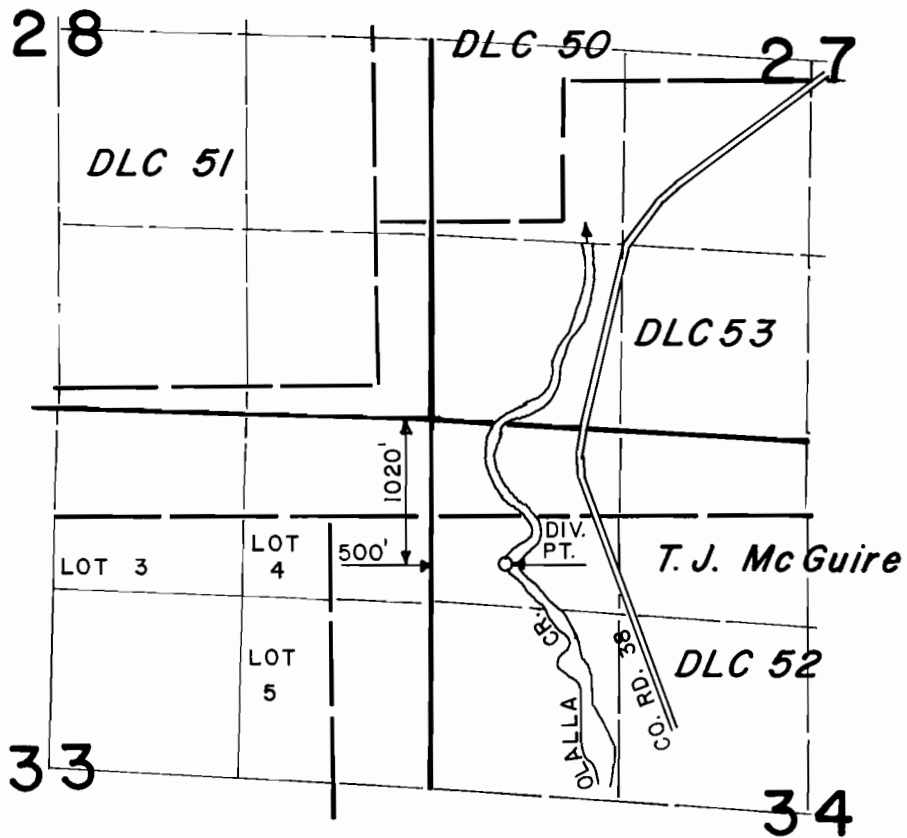

SCALE: 4" = 1 MILE

FINAL PROOF SURVEY
UNDER

TRANSFER NUMBER T-4739

IN NAME OF

ISAAC JAMES & JOHN B. SHOEMAKER

Surveyed MAY 14 1987, by J. M. SCHMORDE.