


T. 4S., R. 12 & 13E., W. M.

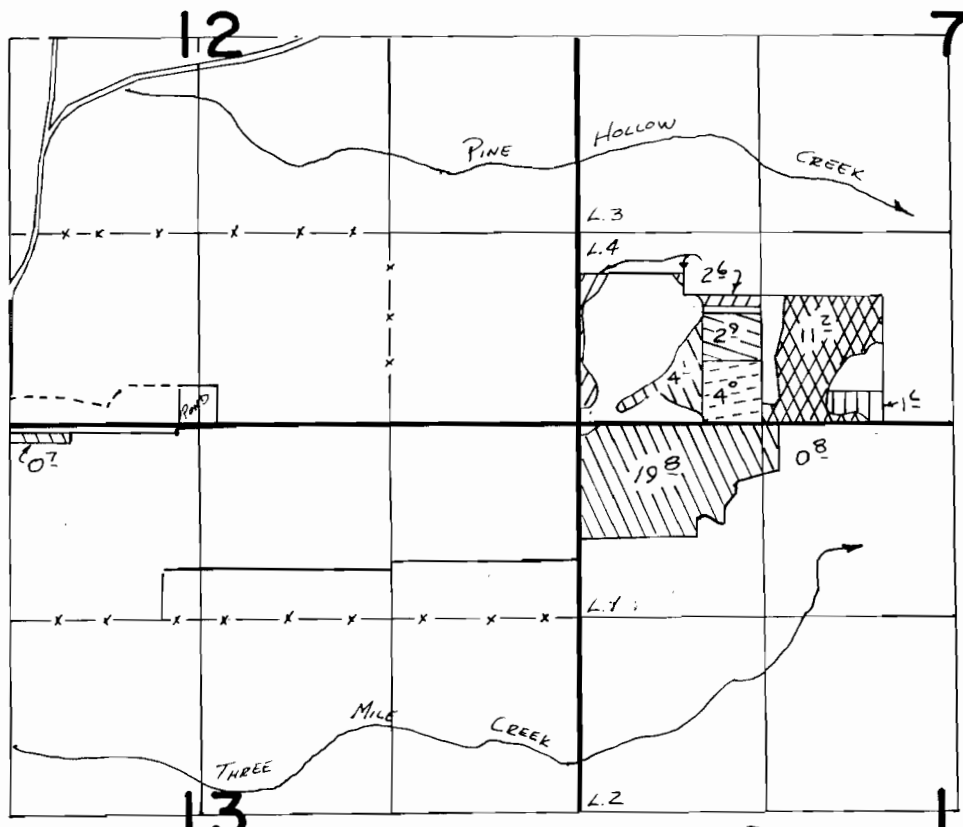

SCALE 1" = 1320'

-  T-4324
-  T-4313
-  T-4312
-  -Prim
T-4314
-  -Suppl
T-5553

FINAL PROOF SURVEY
UNDER

TRANSFERS 4324, [REDACTED] 4312, 4314, 5553
IN NAME OF

.....RAY.....A.....BENZEL.....

Surveyed 10-18-1988, by V.L. Church.....