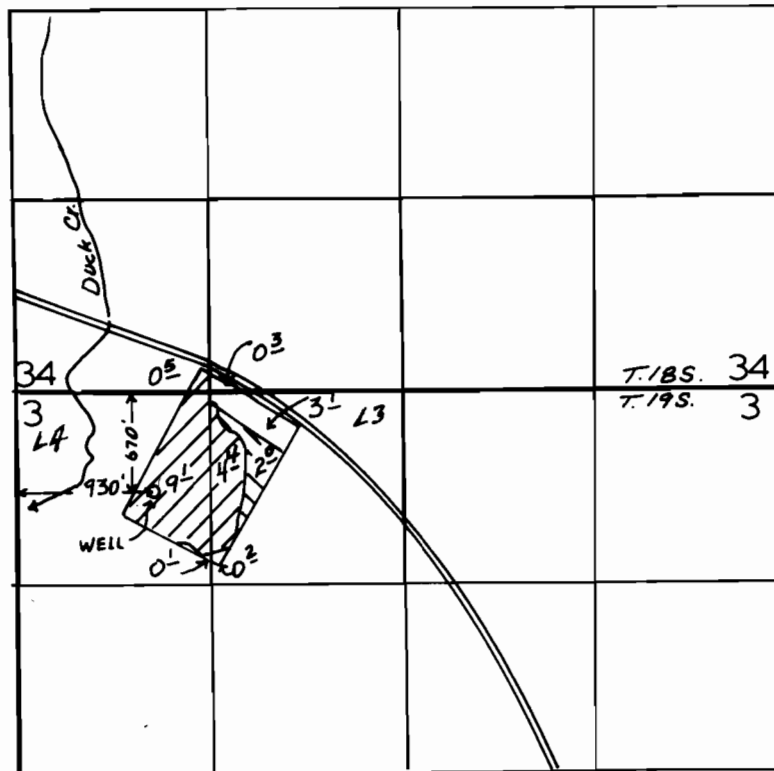


T. 18 & 19 S., R. 33 1/2 E., W.M.


$$1'' = 1320'$$

PRIMARY

SUPPLEMENTAL

FINAL PROOF SURVEY

UNDER

Application No. G-10082 Permit No. G-9517
IN NAME OF

MIKE JOHNSON

Surveyed JULY 6, 1994, by J. MILLER