


T. 33 S., R. 29 E., W.M.

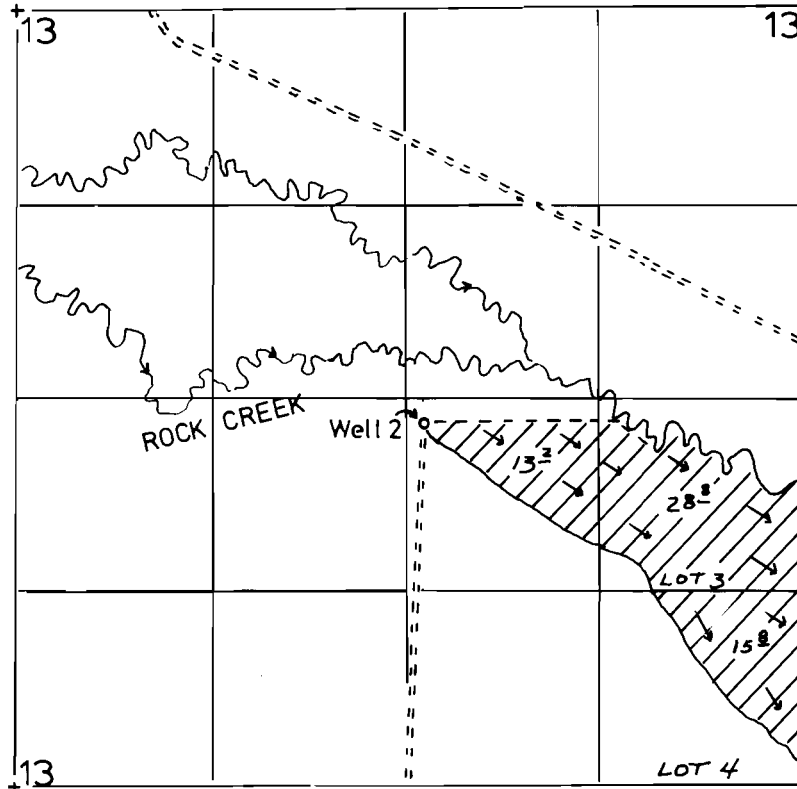

WELL - 180' S. & 120' E. from the Center 1/4, SECTION 13.

FINAL PROOF SURVEY
UNDER

Application No. G-6434 Permit No. G-8054
IN NAME OF

ROCK CREEK RANCH, INC.

Surveyed JULY 16, 1996, by J. MILLER