


T. 8 S., R. 25 E., W. M.

RECEIVED

MAY - 2 1997

WATER RESOURCES DEPT.
SALEM, OREGON

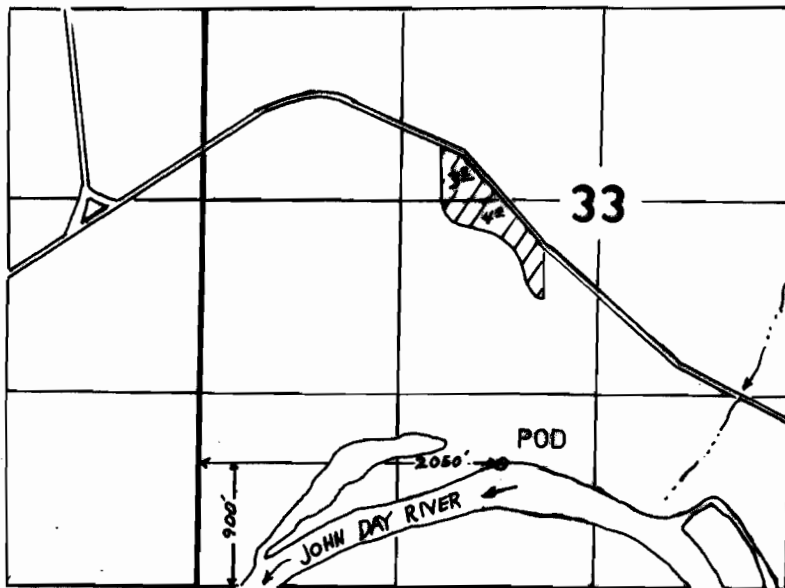

1" = 1320'

FINAL PROOF SURVEY
UNDER

Application No. 6440..... Permit No. 47552.....
IN NAME OF

JACK B. AND DOROTHY B. GAYER.....

Surveyed JUNE 6... 1985.., by J. MILLER.....