


T. 23 S., R. 34 E. W.M.

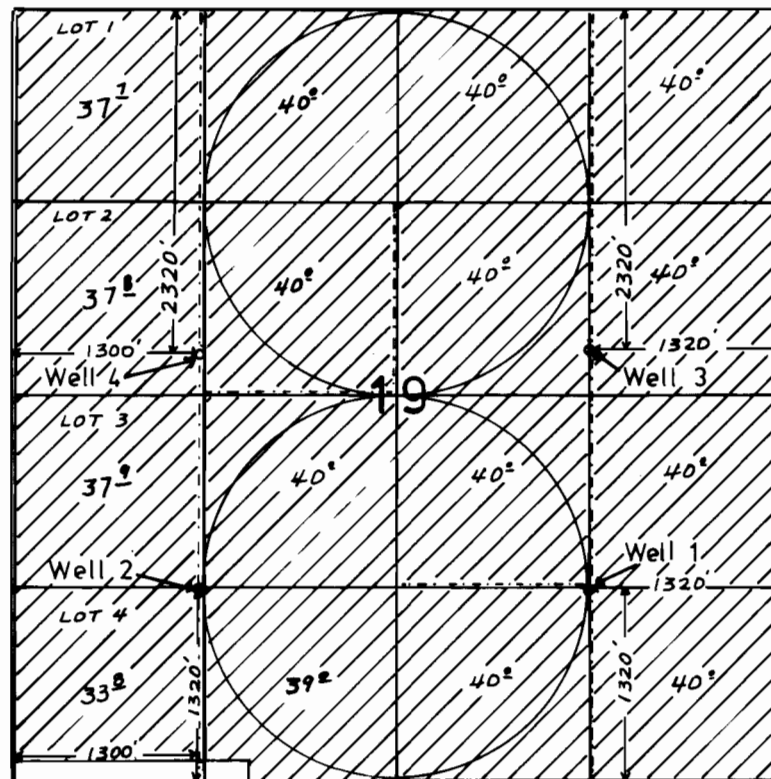

1" = 1320'

FINAL PROOF SURVEY

UNDER

Application No. G-8493 Permit No. G-7664
IN NAME OF

Surveyed NOVEMBER 24, 1992, by J. MILLER