


T. 23 S., R. 33 E., W.M.

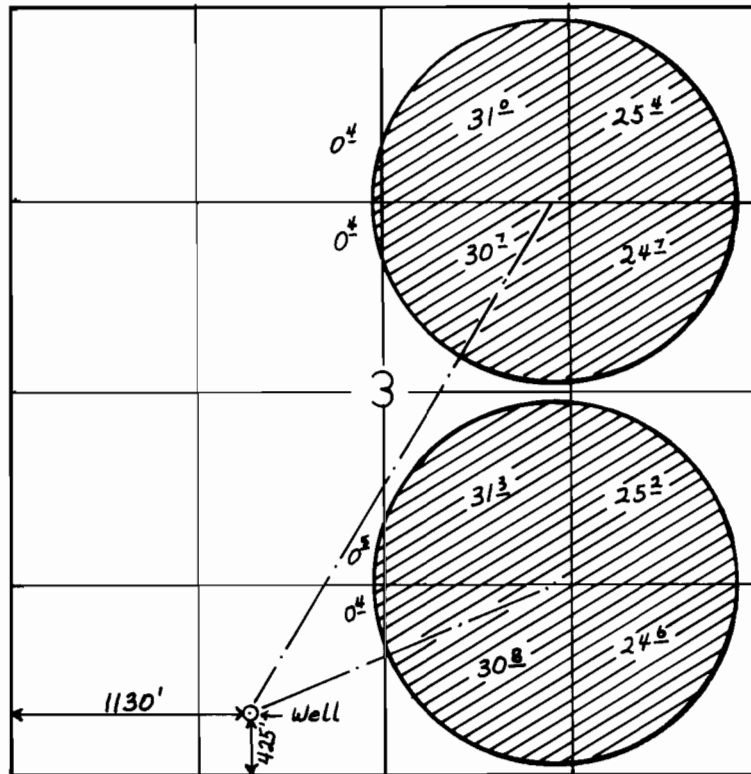

FINAL PROOF SURVEY

UNDER

Application No. G-8346 Permit No. G-7837
IN NAME OF

Surveyed 10-31, 1990, by K. KEMP

Drafted 3-30-93 JM 41025-179-36R