


11671 P. 8108
823L

Twp 12 S R 26 E. W.M.

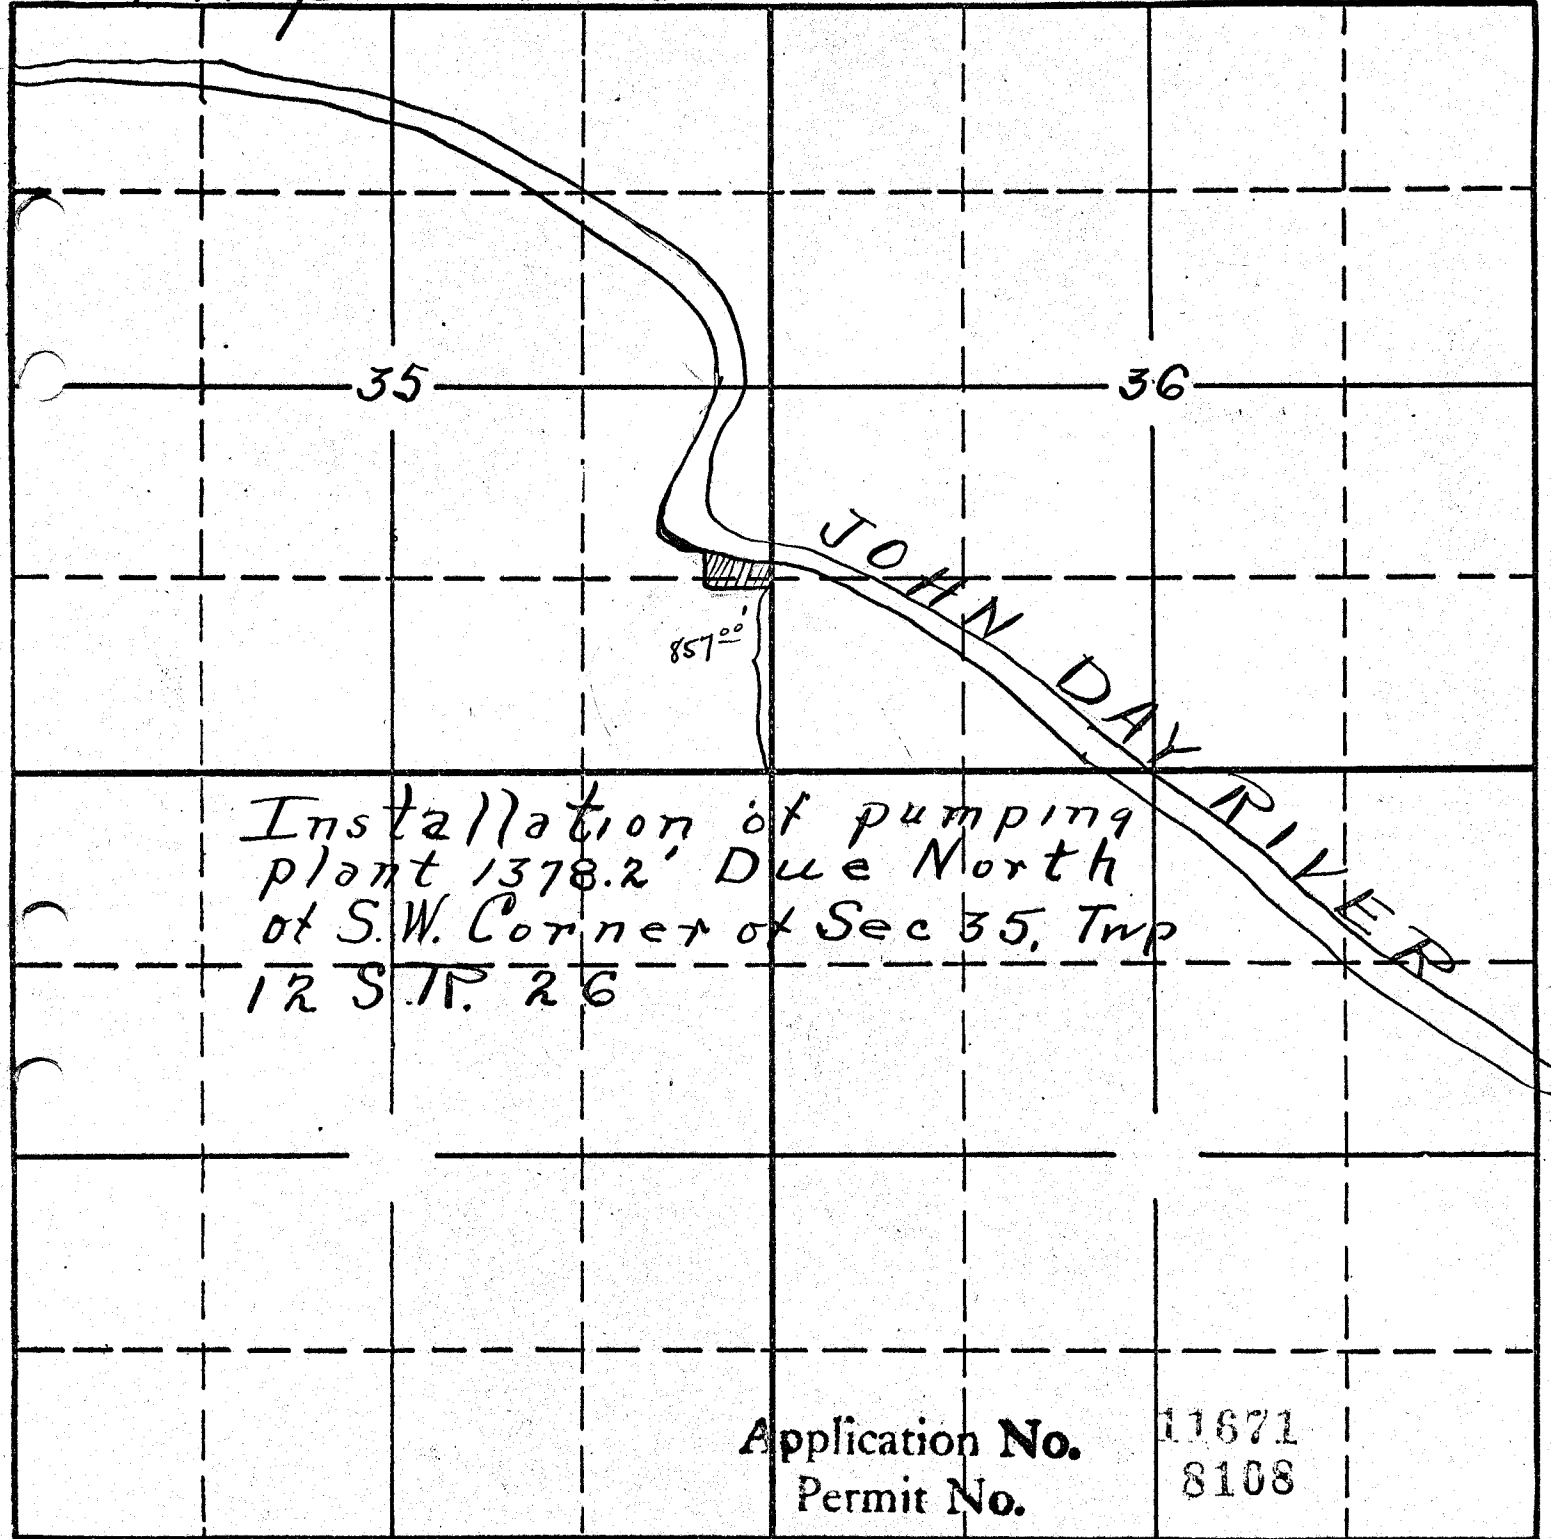

Installation of pumping
plant 1378.2' Due North
of S.W. Corner of Sec 35, Twp
12 S. R. 26

Application No. 11671
Permit No. 8108

Sec. _____
Tp. _____
R. _____