


T. 24 S., R 29 E., W. M.

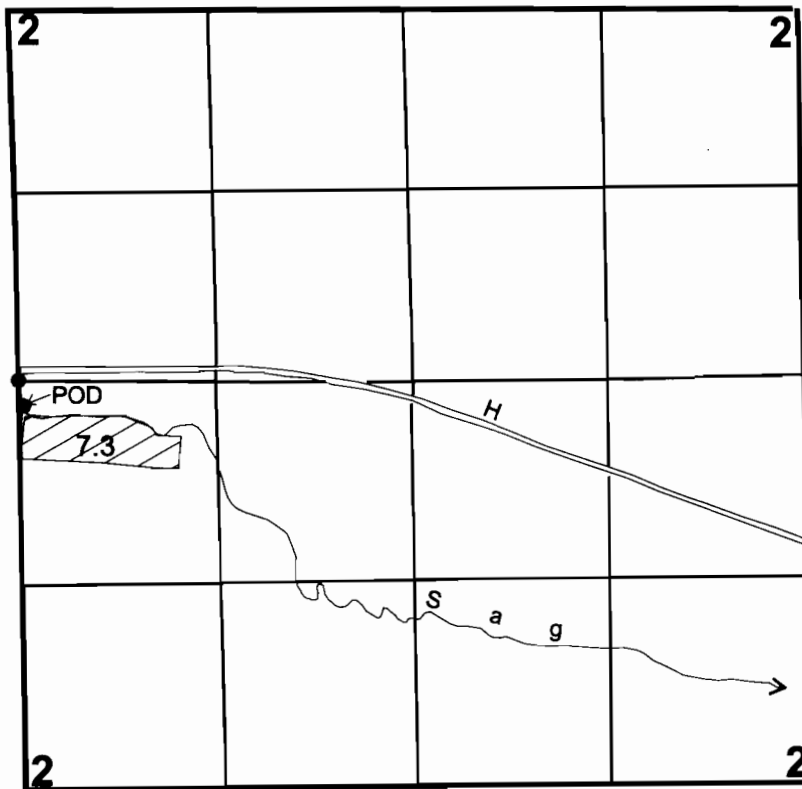

1" = 1320'

POD - 177' South and 27.5' East from the West Quarter Corner of Section 2.

FINAL PROOF SURVEY

UNDER

Application No. 68845 Permit No. 49938

IN THE NAME OF

James A. and Ramona J. Bishop

Surveyed 08-07-2001, by J. Miller