


Township 9 S., Range 27 E., W.M.

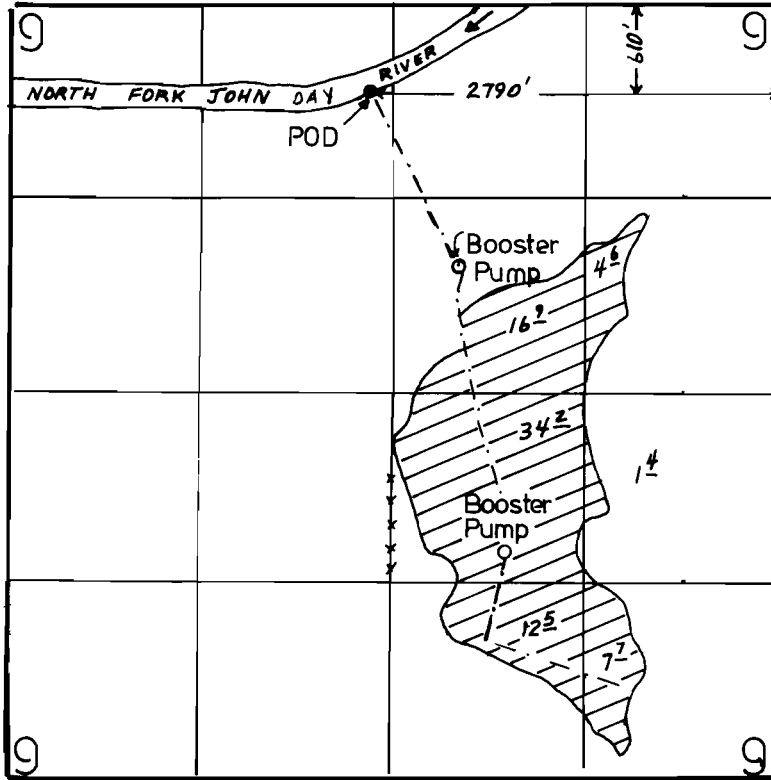

1" = 1320'

FINAL PROOF SURVEY
UNDER

Application No. 57442 Permit No. 43253

IN NAME OF

JOHNNY and HENRY VIOLINI

Surveyed AUG. 27, 1999, by J. Miller

41023-179-123L 1-6-2000 JM