


Township 7 S., Range 29 E., W.M.

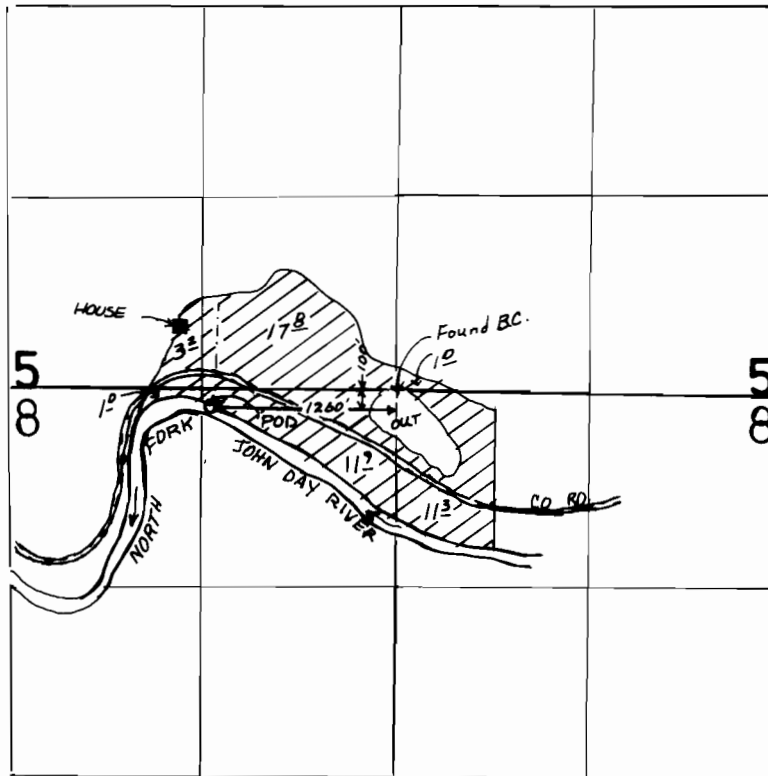

1"= 1320'

**FINAL PROOF SURVEY
UNDER**

Application No. 68605 Permit No. 49562
IN NAME OF

JAMES L. AND SHIRLEY R. WESTBROOK

Surveyed SEPT. 16 99 by J. Miller
19....., by