


Township 11 S., Range 35 E., W.M.

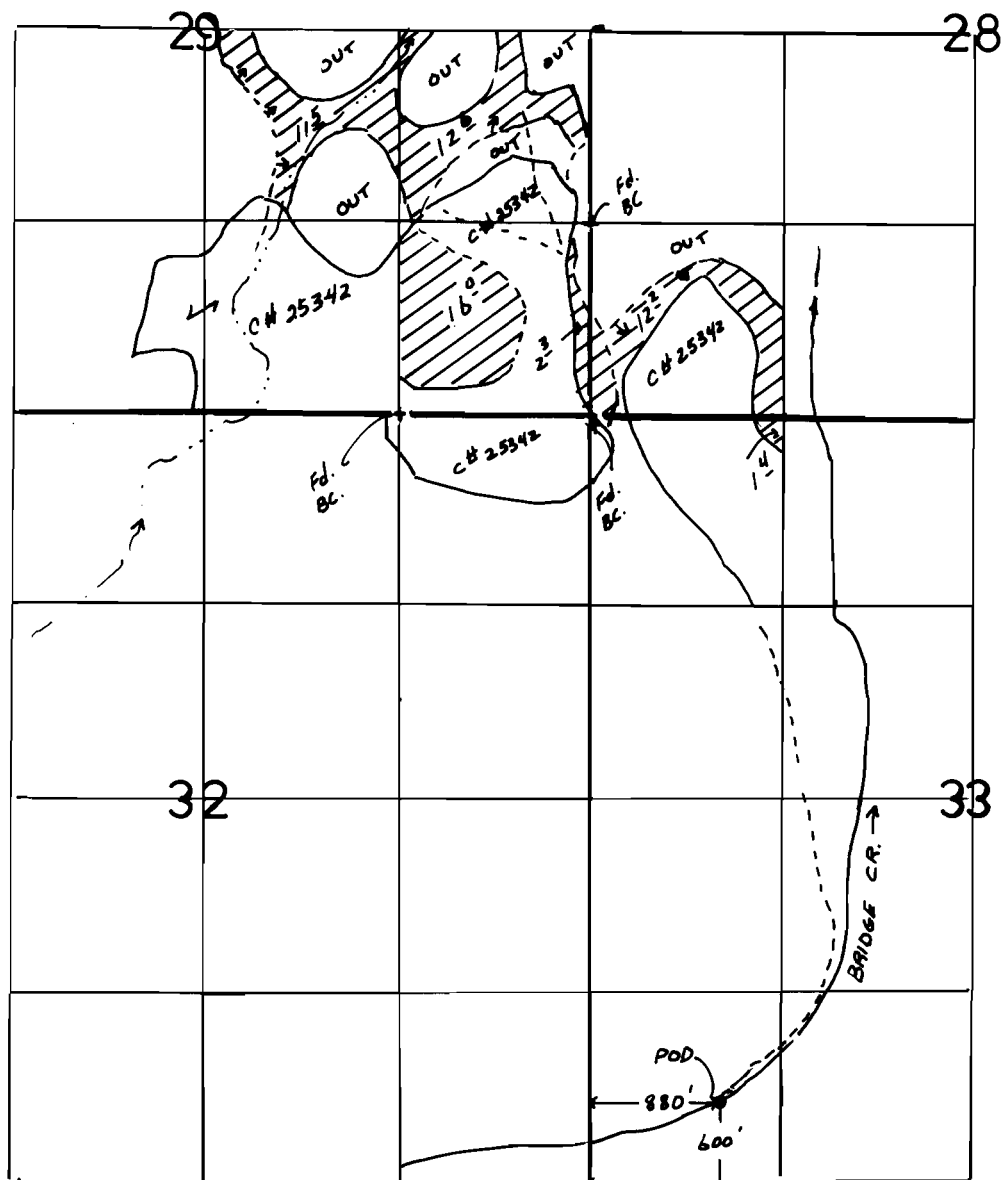

FINAL PROOF SURVEY UNDER

Application No. 54,980.... Permit No. 41,260.....
IN NAME OF

.....RUSSEL STEPHEN RICCO.....

Surveyed Aug. 28, 1999, by J. Miller
July 13, 2000 J. Miller

1" = 1320'