


T. 16 S., R. 18 E., W.M.

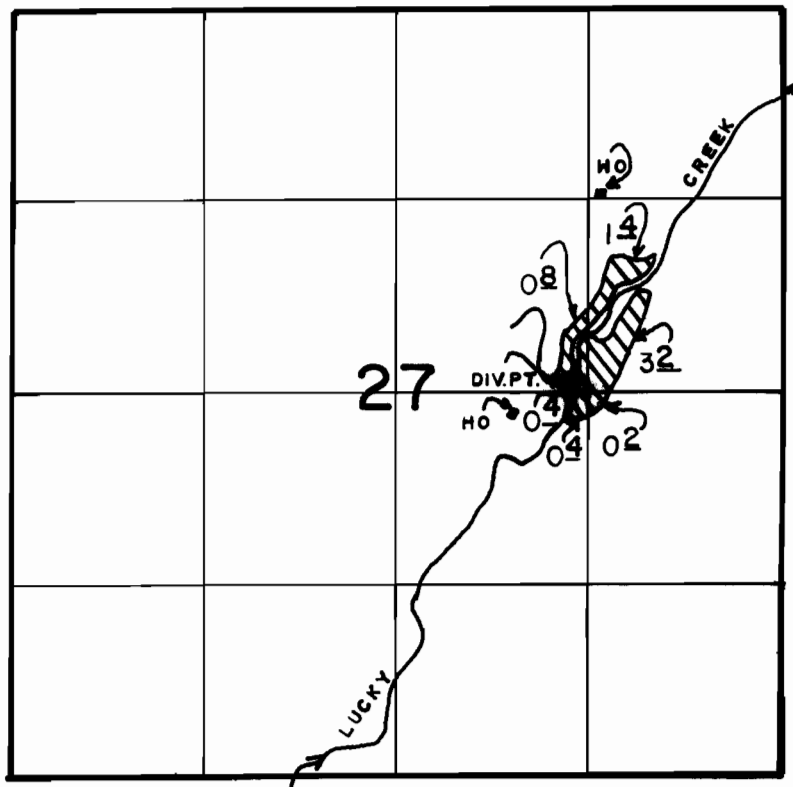

DIV. PT. 2620'S & 1500' W FROM NE COR. OF SEC 27.

SCALE: 1" = 1320'

FINAL PROOF SURVEY

UNDER

Application No. 55025 Permit No. 41278
IN NAME OF

JOHN & DOLLY BEOLETTO

Surveyed NOV 3, 1992, by R.M. SUTTERFIELD