


Township 8 S., Range 31 E., W.M.

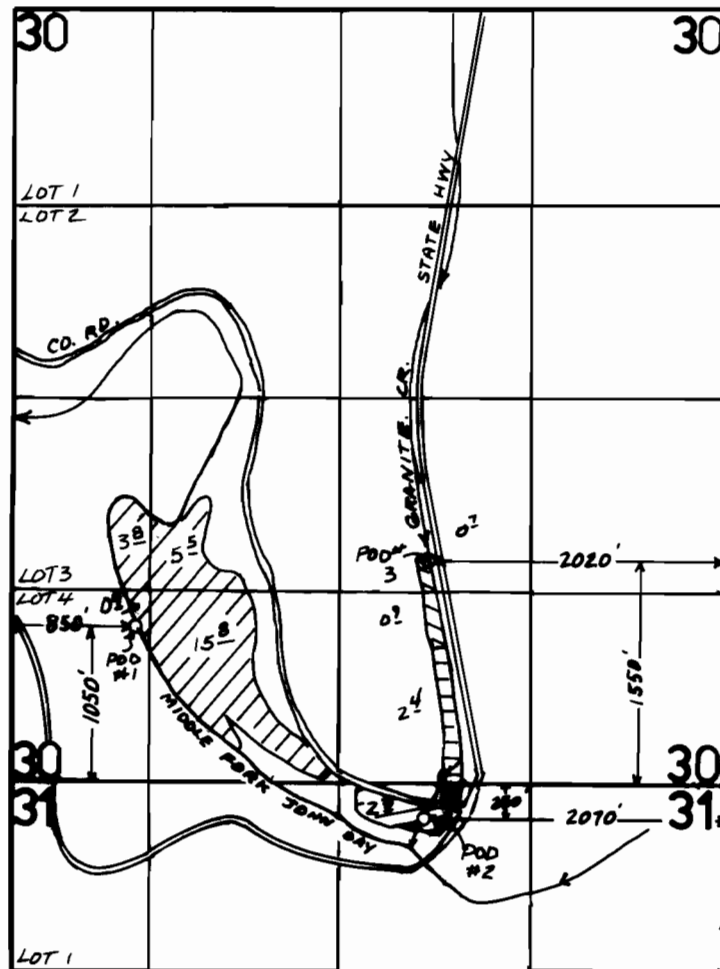

-  POD 1
-  POD 2
-  POD 3
-  C-50135

1" = 1320'

FINAL PROOF SURVEY
UNDER

Application No.61001. Permit No.45465.....
IN NAME OF

.....
Surveyed October 6 19. 99, by J. Miller
.....