


T. 14 S., R. 30 E., W.M.

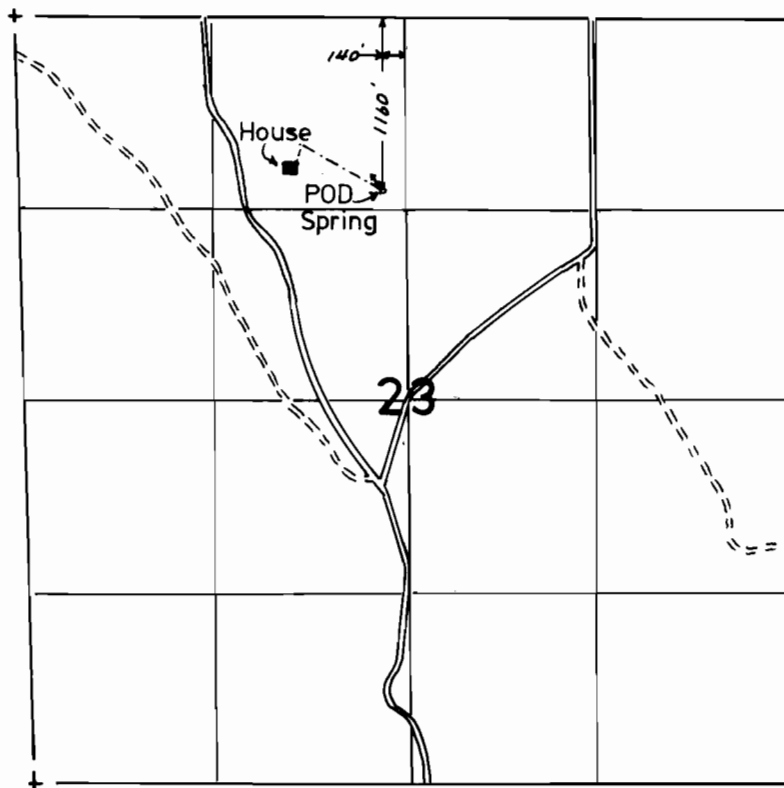

FINAL PROOF SURVEY

UNDER

Application No. 57610 Permit No. 43719

IN NAME OF

IVAN AND ELAINE MULDER

Surveyed DECEMBER 5, 1991, by J. MILLER