


T. 8 S., R. 28 E., W.M.

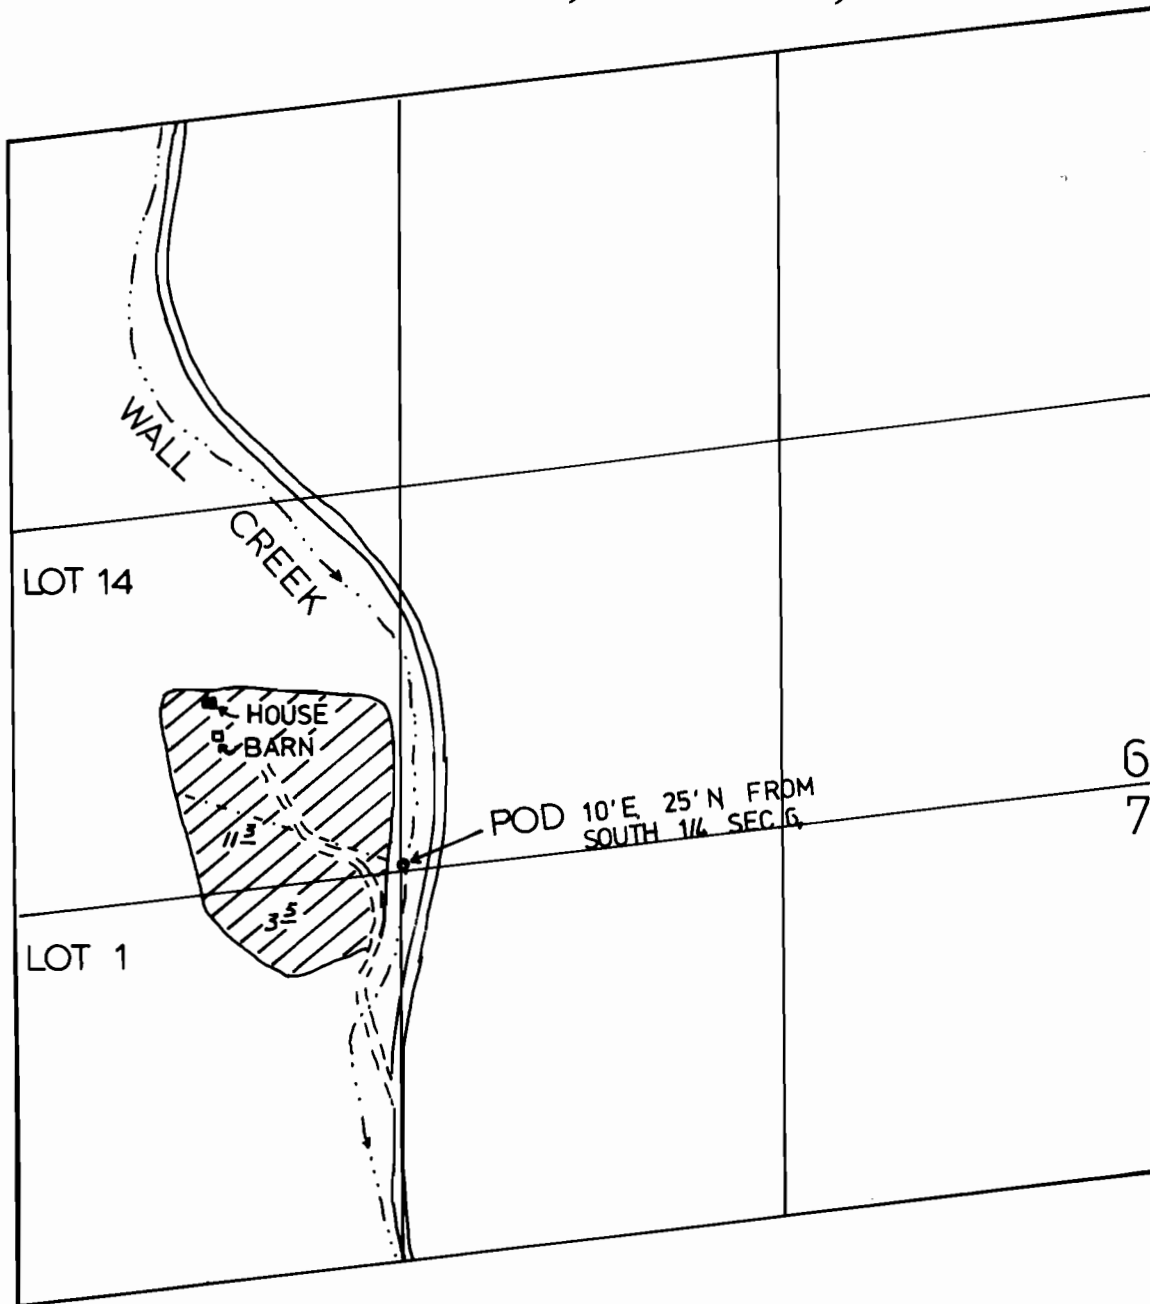

1" = 660'

FINAL PROOF SURVEY

UNDER

Application No. 46664 Permit No. 34864
IN NAME OF

C. J. LAWRENCE

Surveyed AUGUST 28, 1992, by J. Miller