
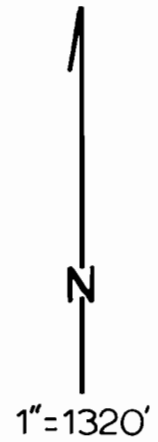


T. 27 S., R. 34 E., W.M.

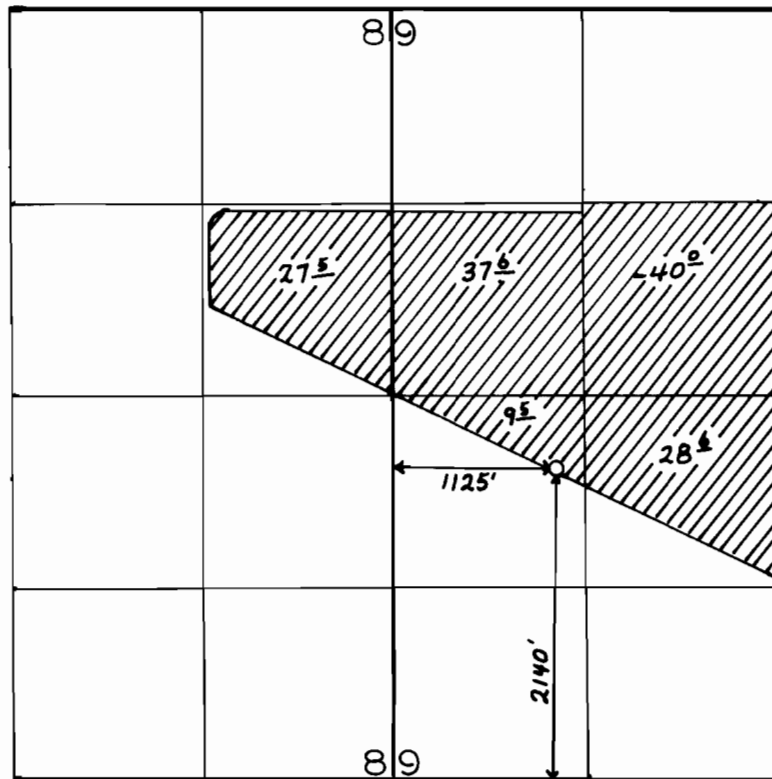

FINAL PROOF SURVEY

UNDER

Application No. G-9017 Permit No. G-8592
IN NAME OF

WARREN MATHEWS

Surveyed 10-31, 1990, by K.KEMP