


# T. 27 S., R. 34 E., W.M.

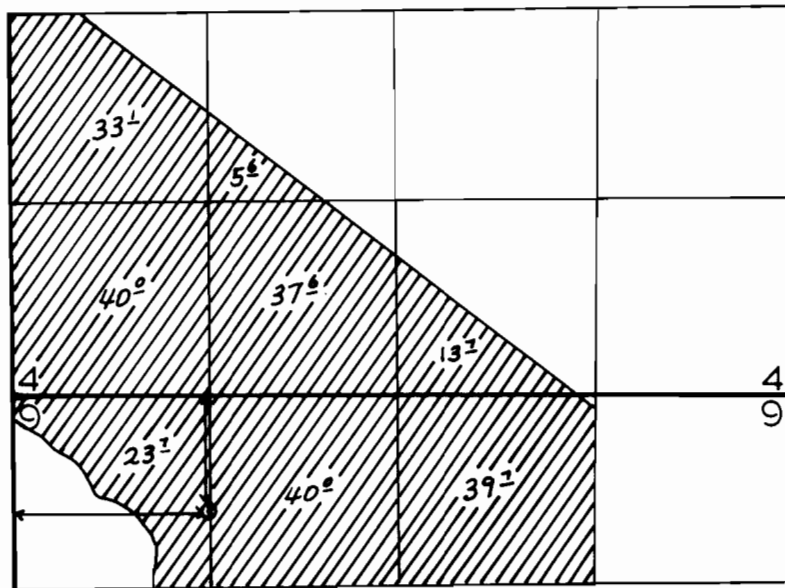

DIV PT - 1300 feet East and 800 feet South from  
NW Corner Sec 9.

## FINAL PROOF SURVEY

UNDER

Application No. G-9018 Permit No. G-8593  
IN NAME OF

WARREN MATHEWS

Surveyed 10-31, 1990, by K.KEMP

*Drafted 3-18-93 J.M 41025-279-1044*