T. 24 S., R. 30 E., W. M.

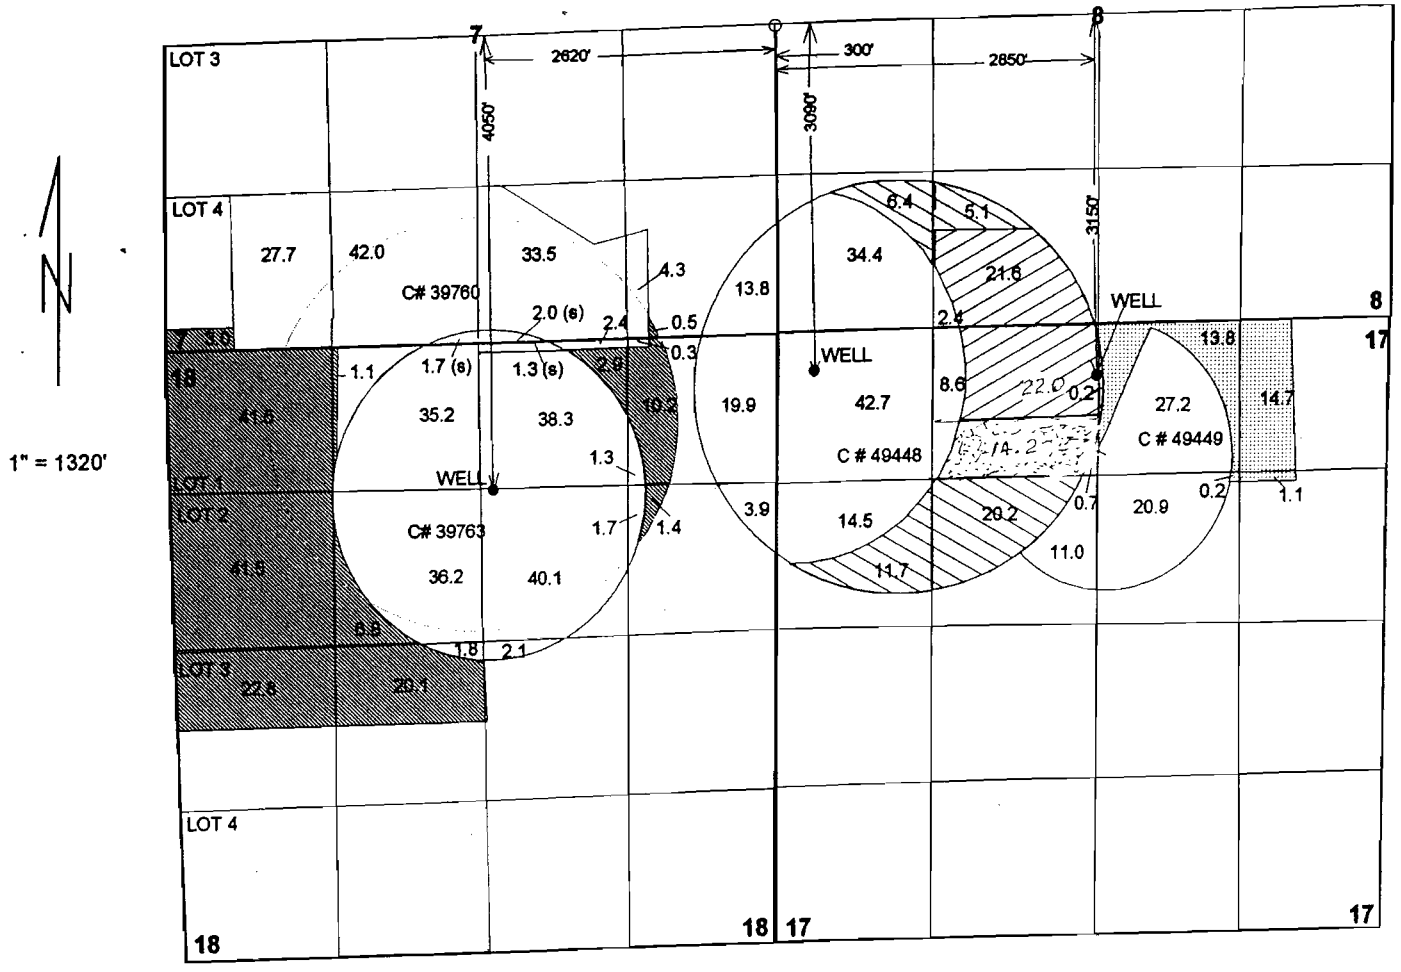

FINAL PROOF SURVEY

UNDER

Transfer No. 4375
Transfer No. 4376

Application No. G-9522 Permit No. G-9382
G-9858 G-9460

IN THE NAME OF

Surveyed 8-8-2001 by J. Miller

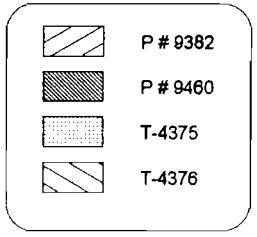

AMENDED 4/25/06 LHN

41025-279-133D & LIEKA GPS JM 3-15-2002