


4670

Geo. H. Smith

Scale 2" = 1 Mile. Aug. 1927

T. 39 S., R. 8 W., W.M.

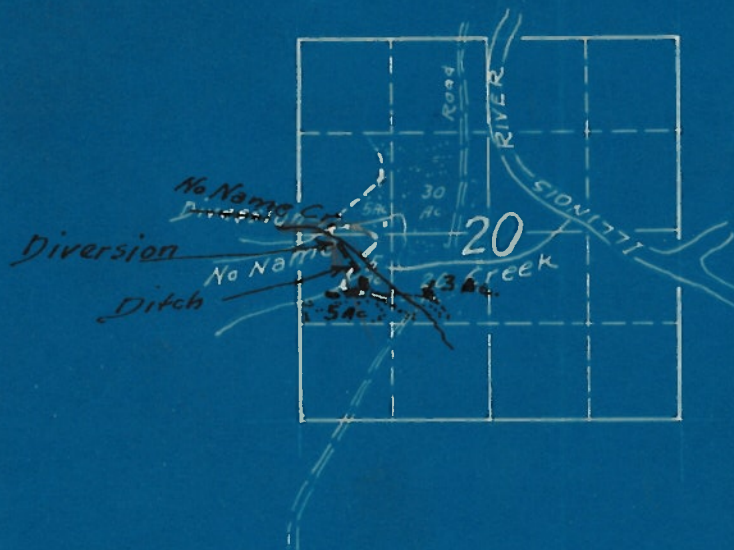

6117