


T. 4 S., R. 28 E., W.M.

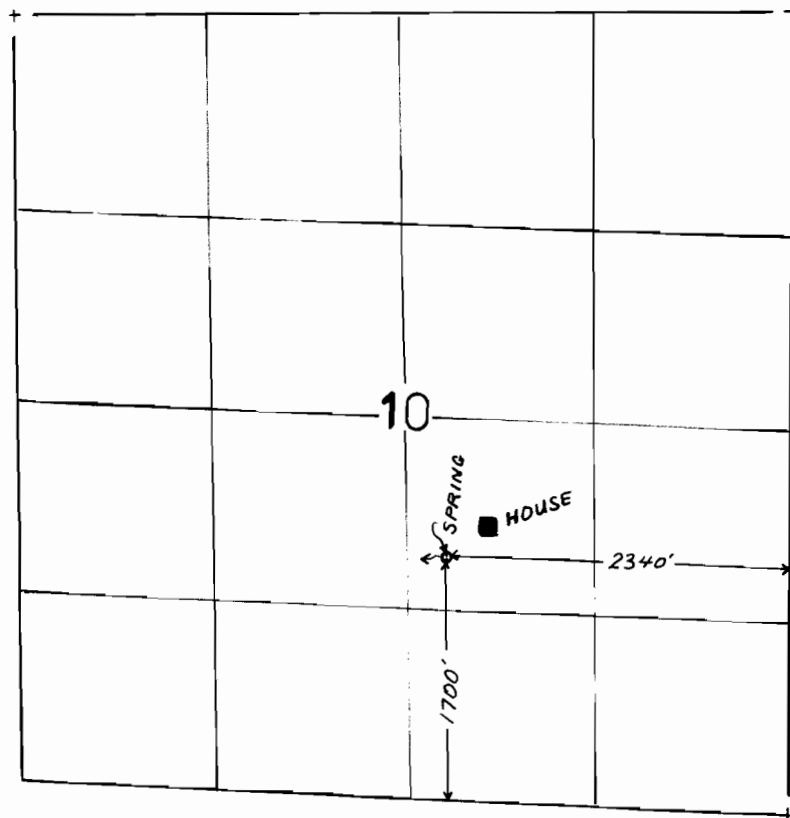

N
1" = 1320'

FINAL PROOF SURVEY

UNDER

Application No. 56632 Permit No. 42420

IN NAME OF

WILLIAM R. SCOTT

Surveyed 9-10, 1993, by J. MILLER